

GOVERNMENT CORNER RESTORATION FORM

FILED

TOWNSHIP 25S RANGE 2W SEC. 15 PLSS # 400400

Date: 7/20/2022 By: [Signature]
This survey consists of:

DOUGLAS COUNTY OREGON

DATE 3-3-22

Map: _____

Narrative: _____
Corner Rpt: CS 67/52-27

Corner Designation

see Cor $\frac{16}{21} | \frac{15}{22}$

DOUGLAS COUNTY
SURVEYOR

Monument(s) Found: (Condition and Source)

___ Condition report

3/4" BLM BRASS CAP ON IRON
PIPE PROJECTING 4". 1 3/4" I.D
PIPE PROJ 15" ON S. EDGE B.C

___ Not Found

Renewed

___ Unrecorded

Previous Renewals

___ Surveyed In

Hosford 1957 CS 42/308

BLM Resurvey 1962 Vol 32

pgs 13226-7

BLM Resurvey 2001-2002 Vol

54 pgs 20927-8

Smalley 2009 CS 45/66-45

BLM Resurvey 2014-2015 Vol

58 pgs 23336-7

Accessories Found

BT'S By Hosford Reported by Skeesick

Burnt dead 21" Hemlock S 21° W 87° FT (Rec 87^B)

PK RIGHT SIDE CENTER HEALED BLAZE

Burnt Broken 26" x 14' Red Cedar SWAG N 143° W

14^B (Rec 14^B) TO PK RIGHT SIDE CENTER

HEALED BLAZE

BT'S By Brooks Reported by Skeesick

41" Burnt dead Red Cedar S 23 1/2° E 57° FT

(Rec 57^A) PK RIGHT SIDE CENTER HEALED BLAZE

BT By Roseburg Resources

18" Burnt dead D. Fir N 12° E 12 1/2 FT (Rec 12^A)

PK RIGHT SIDE CENTER HEALED BLAZE

MONUMENT DETAIL

T 25S R2W

$\frac{516}{521} | \frac{515}{522}$

1962

RENEWAL

Monument Set (Procedure and Description)

MONUMENT DETAIL

New Accessories

Sketch of Monument, Accessories, and General Area

Location & Comments

MONUMENT IS ON EDGE OF
LARGE BENCH AT TOP ON N.W
SLOPE RECENT CLEARCUT IN
S.E. QUADRANT

CORNER IS APPROX
500 FT NORTH OF
E-W GRAVEL ROAD

AREA BADLY BURNT
9-2020

LAT 43° 23' 17.49" N
LONG 122° 56' 01.42" W

Comp. Decline. 14 1/2° E


Agency DCSB

Party Chief S. FLOUSE

Note keeper

Witnesses J LORSUNG

See Attached Sheet for
Sketch

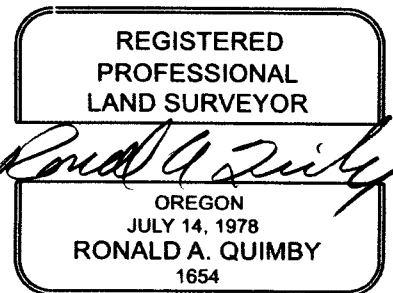

EXPIRES: 12/31/2022

CS 67/52-27
214

T25S; R2W, 400400


3/3/22

| | |
|-----|-----|
| 516 | 515 |
| 521 | 522 |

1957 B.T.
BURNED DEAD
BROKEN R. CEDAR SNAG
N43°W, 143'

1997 RFP B.T.
BURNED DEAD
18" D. FIR
N12°E, 121'

B.C.

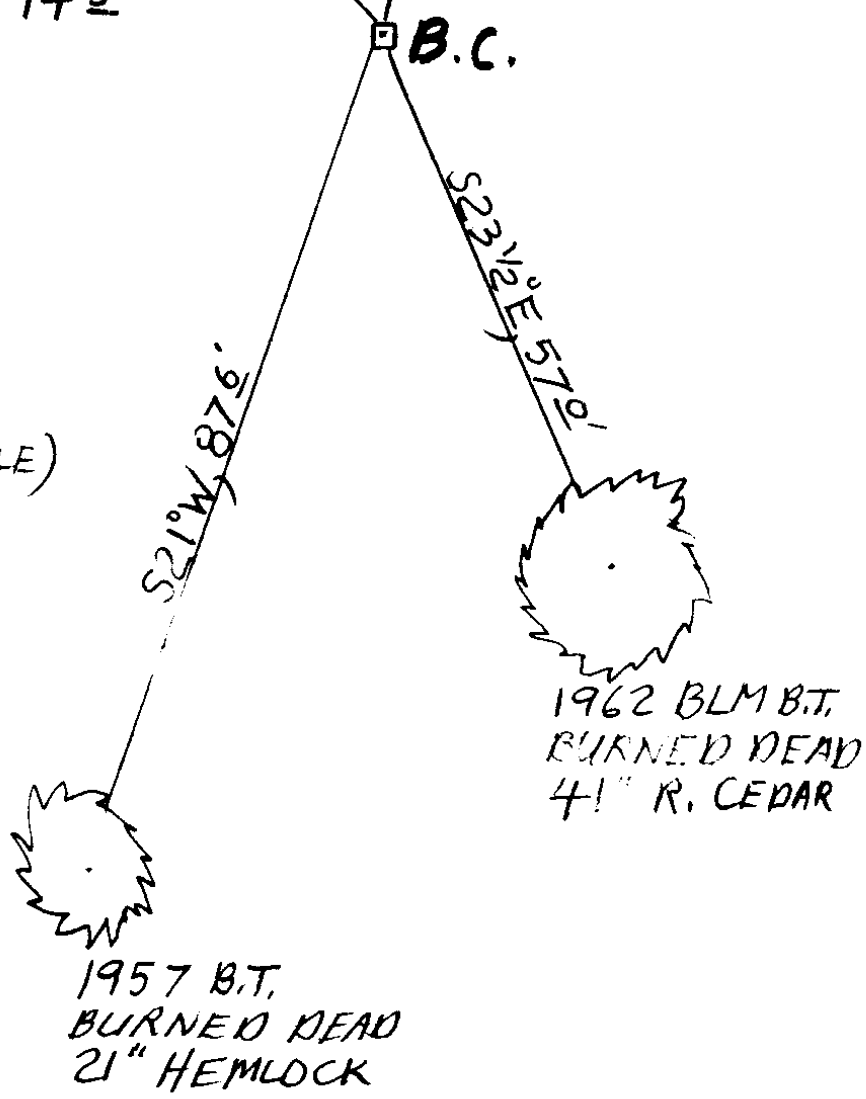

1962 BLM B.T.
BURNED DEAD
41" R. CEDAR

DECLINATION 14 1/2° E

CS 67/52-27
314

MM GPS 3/3/22
TIME - 9:00
H.I. - 2,000M

3/3/22

TOWNSHIP 25 RANGE 02 POINT IDENTIFIER # 400400

PRIMARY CORNER DESCRIPTION Cor Secs 15, 16, 21, & 22

| Alias | Description |
|-------|-------------|
| Alias | Description |
| Alias | Description |
| Alias | Description |

13" Hemlock S.78°30'W., 23.8', 1900, gone.
 14" maple N.68°W., 18.5', 1900, gone.
 7" Hemlock, N.52°E., 25.1', 1900, gone.
 New - Set Oct. 1997 by Roseburg Forest Products but not recorded:
 17" D.Fir N.12°E., 12.4' measured to side center of root crown, scribed "S15BT" but now healed face-1997 Compass decl. 18°E.

BLM Dependent resurvey by Richard J. Dieckmann, Cadastral Surveyor, under Group No. 2749, surveyed Aug. 2014/April 2015 - (DCSO records Vol. 58 Page(s) 23336-7)

The cor. of secs. 15, 16, 21, & 22, perpetuated by Roseburg Resources in 1997 as reported by Smalley, in 2009, monumented with an iron post, 2 1/2" dia., firmly set, projecting 2" above the top of a mound of stone, 2 1/2 ft. base, 6" high, with a brass cap (properly) mkd. AND 1 3/4" I.D. IP. ON SOUTH EDG. BC PROT 15" ABOVE GROUND.

3 1/4" BC PROP. MKD.
 NOW PROT 4" ABOVE GROUND
 1 1/2 FT DIAM
 ROUGH MOUND OF STONE

BURNED DEAD

BURNED DEAD BROKEN
26" x 14 FT SNAG

BURNED DEAD

BURNED DEAD

21" A hemlock, 21" dia., bears S.21°W., 87.6 ft., with a healed blaze. ~~87.8~~ RSC PK
 A red cedar, 28" dia., bears N.43°W., 14.3 ft., with a healed blaze. ~~14.5~~ RSC PK
 and the BT mkd by Brooks in 1962, reported by Skeesick
 41" A red cedar, 41" dia., bears S.23 1/2°E., 57.2 ft., with a healed blaze. ~~57.4~~ RSC PK
 and a bearing tree mkd. by Roseburg Resources
 18" A D. Fir, 18" dia., bears N.12°E., 12.4 ft., with a healed blaze. ~~12.4~~ RSC PK

The geographic position in NAD 1983 (2011)
 Latitude: 43°23'17.50" N. Longitude: 122°56'01.36" W

MONUMENT IS ON EDGE OF LARGE BENCH AT TOP OF NW SLOPE
 FOREST RECENTLY CLEARCUT IN SE QUAD.
 MONUMENT IS APPROX 500 FT NORTH FROM E-W RUNNING GRAVEL RD.
 DECLINATION 14 1/2° E

CS 67/52-27
4/4 3