

GOVERNMENT CORNER RESTORATION FORM

FILED

TOWNSHIP 255 RANGE 1 W SEC. 10 PLSS # 440500

Date: 7/20/2022 By: JC

This survey consists of:

DOUGLAS COUNTY OREGON

DATE 4-5-22

Map: _____

Narrative: _____

Corner Rpt: CS 67/52-32

Corner Designation

1/4 COR 10/15

DOUGLAS COUNTY SURVEYOR

Monument(s) Found: (Condition and Source)

3 1/4" BRASS CAP
projecting 3"

___ Condition report

___ Not Found

___ Renewed

___ Unrecorded

___ Surveyed In

Previous Renewals

DCSO 1962 CS 52/30-9

Shrum 1968 CS 55/106

BLM Resurvey 1978-1980

Vol 42 pg 16366

BLM Resurvey 2010-2011

Vol 57 pg 22822

MONUMENT DETAIL

T 255 R1W

1/4 510/515

2011

Accessories Found

R.M's by Jolley 1978-1980

3 1/4" BRASS CAP ON IRON PIPE PROJ 1"
BEARS N 1° 55' 55" E 10.89 FT (Rec North)

3 1/4" BRASS CAP ON IRON PIPE BEARS
S 70° 29' 21" E 5.28 FT (Rec S 69° E 5.2 FT)

ORIG BT

Decayed Hemlock Stump Nearly burnt
AWAY S 51° E 18.5 FT

RENEWAL

Monument Set (Procedure and Description)

MONUMENT DETAIL

New Accessories

Sketch of Monument, Accessories, and General Area


Location & Comments

LAT 43°24'27.74"N
 LONG. 122°47'32.43"W

AREA BURNT
 9-2020

For sketch see attached
 sheet.

Comp. Decline. 14 1/2° E
 Agency DCSO
 Party Chief S. Flouse
 Note keeper
 Witnesses J. LORSUNG

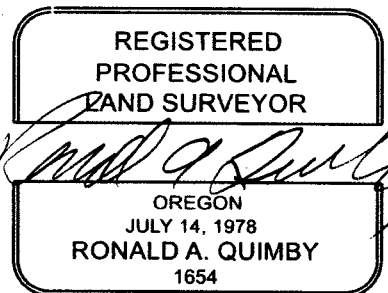


CS 67/52-32
 215

T25S, R1W, 440500

4/5/22

1/4 S10
S15

2011-2012
BLM RESURVEY
3 1/4" BC/IP
REF. MON.

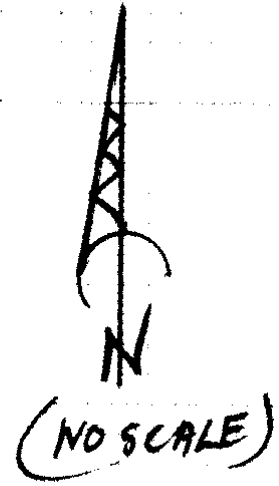

N02°E 1089'

B.C.
MON.

S70 1/2°E 528'

2011-2012
BLM RESURVEY
3 1/4" BC/IP
REF. MON.

S51°E 185'

O.B.T.
ALL BUT BURNED AWAY
HEMLOCK STUMP

DECLINATION 14 1/2°E

ENDRO
DATE 10/18/21
BY [unclear]

CS 67/52-32
3/5

4/5/22

PRIMARY CORNER DESCRIPTION 1/4 Cor Secs 10 & 15

Alias _____ Description _____
Alias _____ Description _____
Alias _____ Description _____
Alias _____ Description _____

GLO Survey by Hezekiah H. Johnson, under Contract #721, dated May 1, 1900 (DCSO records Vol. 9 Page(s) 3537)

Summit of spur slopes N
A Hemlock, 6" dia., I mark 1/4 S10 on N, S15 on S sides, for 1/4 sec. cor., from which
A dogwood, 6" dia., bears N.5°E., 26 lks., mkd: 1/4 S BT.
A hemlock, 12" dia., bears S.51°E., 28 lks., mkd: 1/4 S BT.

Douglas Co. Surveyors Office - Milo E. Godfrey, Deputy - Vernon Tracy - Clete Putnam - June 6, 1962 - C.S. 52/30-9

Found - Hemlock, now 8", at corner. N face opened & good scribing "1/4S" visible on old face.
Hemlock, now 18", S.51°E., 18.5 ft. Has been opened previously & good scribing "1/4 S15" visible on old face.
6" Dogwood N.5°E., 17.2 ft., shows scar.
New - 8" Hemlock N.25°E., 33.2 ft mkd: 1/4 S10 CS BT.
Drive 3/4" Iron rod at Base of Corner Tree.

FD. 2 Hemlock stumps & added a L Steel fence post- by Thomas Shrum, Nov. 1968 - C.S. File 55/106

BLM Dependent resurvey by James E. Jelley, Cadastral Surveyor under Group #350 & 929 surveyed May 1978/May 1980 - (DCSO records Vol. 42 Page(s) 16366)

The 1/4 sec. cor., of secs. 10 and 15, perpetuated and recorded by Godfrey, in 1962, monumented with the remains of the orig. corner tree, a hemlock stump, 10" dia., no marks visible, from which the remains of the original BTs:
A sawed dogwood stump, 6" dia., bears N.5°E., 26 lks., no marks visible.
A sawed hemlock stump, 17" dia., bears S.51°E., 28 lks., with scribe marks 4 S15 BT visible on open blaze.
and the remains of a bearing tree mkd. by Godfrey
A sawed hemlock stump, 8" dia., bears N.25°E., 51 lks., with scribe marks 1/4 S10 CS BT visible on open blaze.
add reference monuments
An iron post, 28" long, 2 1/2" dia., set 24" in the ground, for a RM, bears North, 16 1/2 lks., with brass cap mkd. 1/4 S10 RM 1978 & an arrow pointing to the corner.
An iron post, 28", long, 2 1/2" dia., set 24" in the ground, for a RM, bears S.69°E., 8 lks., with brass cap mkd. 1/4 S15 RM 1978 & an arrow pointing to the corner.

continued next page

4/5/22

TOWNSHIP 25 RANGE 01 POINT IDENTIFIER # 440500

PRIMARY CORNER DESCRIPTION 1/4 Cor. Secs. 10 & 15

Alias _____	Description _____
Alias _____	Description _____
Alias _____	Description _____
Alias _____	Description _____

BLM Dependent Resurvey by Kenneth W. Saveland, Cadastral Surveyor, under Group No. 25001006, Surveyed Aug. 2010/April 2011 - (DCSO records Vol. 57 Page(s) 22822)

The 1/4 sec. cor. of secs. 10 and 15, monumented with the remains of the original corner tree, a decayed hemlock stump, size indeterminate, with no marks visible, (alongside of which is a rebar, 3/4" dia., firmly set, projecting 4" above ground) from which the remains of the original bearing trees

A roothole bears N.5°E, 17.2 ft.

ALL BUT BORNE AWAY

A decayed hemlock stump, size indeterminate, bears S.51°E, 18.5 ft., with scribe marks ~~4 S16~~ visible on opened blaze.

GONE NO EVID.

and the remains of a BT mkd. by Godfrey, in 1962

A decayed hemlock stump, size indeterminate, bears N.25°E., 33.7 ft., with no marks visible.

and accessories established by Jelley

ALL BCS 3 1/4"

An iron post, 2 1/2" dia., firmly set, projecting ~~4"~~ above ground, bears N.1°55'55"E., 10.89 ft. with brass cap mkd. 1/4 S10 RM 1978 and an arrow pointing to the corner. (Record, North.)

PROT 1"

An iron post, 2 1/2" dia., firmly set, projecting ~~3"~~ above ground, bears S.70°29'21"E., 5.28 ft. with brass cap mkd. 1/4 S15 RM 1978 and an arrow pointing to the corner. (Record, S.69°E.)

FLUSH WITH GRND.

At the corner point

Set a stainless steel post, 28" long, 2 1/2" dia., 24" in the ground, with brass cap mkd.

MARKED AS DSCRIB

T25S R1W

PROT 3"

1/4 S 10

S 15

2011

Deposit a magnet in a white plastic case at the base of the stainless steel post.

CS 67/52-32
515