

GOVERNMENT CORNER RESTORATION FORM

FILED

TOWNSHIP 265 RANGE 2W SEC. 12 PLS # 700540

Date: 7/20/2022 By: X

This survey consists of:

DOUGLAS COUNTY OREGON

DATE 4-21-22

Map: \_\_\_\_\_

Narrative: \_\_\_\_\_

Corner Rpt: CS 67/52-33

Corner Designation

DOUGLAS COUNTY SURVEYOR

E 1/4 SEC 12 only

Monument(s) Found: (Condition and Source)

\_\_\_ Condition report

DCSD BRASS CAP IN MOUND

\_\_\_ Not Found

OF STONE PROJ 20" SET

Renewed

DEEPER NOW PROJ 8"

\_\_\_ Unrecorded

Previous Renewals

\_\_\_ Surveyed In

GLD Survey 1910 Vol 10 pg 4085

GLD Survey 1913 Vol 10 pg 4265

DCSD 1961 CS 52/77-1

BLM Resurvey 1968 Vol 34 pgs <sup>14269</sup> <sub>E70</sub>

Hoffine 1999 M133-59

Hoffine 2010 M161-10

MONUMENT DETAIL

County Surveyors  
OFFICE  
T265

R2W 1/4 S12 |  
1961

Accessories Found

Burnt off HOLLOWED OUT 38" X 3 1/2" D. FIR STUMP  
54 1/2" W 60.7 FT

Burnt stump 20" X 4' CEDAR N180°W 18.0 FT

Burnt off STUMP 14" X 6 FT D FIR S83 1/2°W  
18.7 FT

Metal Fence post approx 1.0 FT North  
AND West

---



---



New Accessories

5/8" I. Rod inside 3/4" I. Pipe proj 6" N 31 1/2° W  
25.1 FT

5/8" I. Rod inside a 3/4" I. pipe Proj 6"  
N 10° W 65.7 FT

Sketch of Monument, Accessories, and General Area

Location & Comments

LAT 43° 19' 18.23" N  
LONG 122° 52' 24.45" W

See Attached sheet for  
Sketch

AREA BURNED  
9-2020  
Corne is approx  
50' South & 30 FT  
West of Rock  
ROAD  
Comp. Decline. 14 1/2° E  
Agency DCSO  
Party Chief S. Flouse  
Note keeper  
Witnesses J LORSUNG




EXPIRES: 12/31/2022

CS 67/52-33  
2/4

T26S, R02W, 700540

4/21/22

E 1/4  
S 1/2  
ONLY

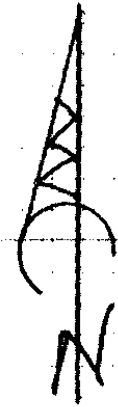

(NO SCALE)

GRAVELLED RD.

NEW REF.  
5/8" I.R. / 3/4" I.P.

NEW REF  
5/8" I.R. / 3/4" I.P.

1910 GLO BT  
BURNED OFF STUMP  
20" x 4' TALL  
N 80° W, 180'

2010 BT  
BURNED OFF STUMP  
14" x 6' TALL  
S 83 1/2° W, 182'

1961 DGSD BT  
HOLLOW BURNED STUMP  
38" x 3 1/2' TALL

N 01° W, 652'

N 13 1/2° W, 252'

S 41 1/2° W, 602'

B.C.

GRAVELLED RD.

DECLINATION 14 1/2° E

CS 67/52-33

3/4

MA 043 4/20  
TIME - 1040?  
HI 2100M

4/21/22

TOWNSHIP 26 RANGE 02 POINT IDENTIFIER # 700540

PRIMARY CORNER DESCRIPTION E. 1/4 Cor. for Sec. 12 only

Alias	Description
Alias	Description
Alias	Description
Alias	Description

Ken Hoffine - For: Lone Rock Timber Management Co. - July 2010 - M161-10  
*MARKED AS DESCRIBED*

Found - 1961 Douglas County brass cap in mound of stones  
D. fir bears S.  $41\frac{1}{2}^\circ$  W., 60 ft (record S.  $43^\circ$  W., 61.2 ft Garrett map M47-7) healed face and tag.  
cedar stump bears N.  $88^\circ$  W., 18.0 ft (as per Garrett map M47-7)

New BT - 18" D. fir bears S.  $83\frac{1}{2}^\circ$  W 18 ft we scribe T26S R2W  $\frac{1}{4}$ S 12BT and tag

Corner is 1.0 ft above ground and approx. ~~35~~ <sup>50</sup> ft south & ~~30~~ <sup>30</sup> ft West of rock road. Put metal fence posts approx. 1.0 ft north and ~~South~~ of corner.

*WEST*

*BURNED OFF FOLLOWED BY STMP 37" x 3 1/2 FT*  
*BURNED OFF STMP 20" x 4 FT*  
*BURNED OFF STMP 14" x 6 FT*

*MOUND OF STONE GONE, PROT. 20"*  
*SET DEEPER NOW PROT. 8"*

*NEW REFS*

*5/8" IR IN  $3\frac{1}{4}$ " 10 IP 26" LONG PROT. 6" N  $31\frac{1}{2}^\circ$  W, 25'*  
*" " " " N  $1^\circ$  W, 65'*

*DECLINATION  $14\frac{1}{2}^\circ$  E*

CS 67/52-33  
414