

GOVERNMENT CORNER RESTORATION FORM

FILED

TOWNSHIP 26S RANGE 1W SEC. 7 PLSS # 100 540
26S 2W 700 530

Date: 7/20/2022 By: JC
This survey consists of:

DOUGLAS COUNTY OREGON DATE 4-21-22

Map: _____
Narrative: _____
Corner Rpt: CS 67/52-34

Corner Designation

W 1/4 cor sec 7 only

DOUGLAS COUNTY SURVEYOR

Monument(s) Found: (Condition and Source)

- Condition report
- Not Found
- Renewed
- Unrecorded
- Surveyed In

2 1/2" DCSO BRASS CAP PROJ
16"

Previous Renewals

GLD 1913 Vol 10 pg 4265
DCSO 1961 CS 52/77-2
BLM Resurvey 1968 pg 14249
Hoffine 2010 M 161-10

MONUMENT DETAIL

County Surveyors
OFFICE
TZLS
| W 1/4 S7 R1W
1961

Accessories Found

Burnt 20" X 5 1/2' FT CHINGUAPIN STUMP N 28° E
(Rec N 29 3/4° E) 47.9 FT
Burnt - DEAD 12" Cedar S 87° 14' E 39.3 FT

CORNER IS 4.09 FT West of SECTION LINE
(Rec 4.14 FT) Per M 161-10

RENEWAL

Monument Set (Procedure and Description)

MONUMENT DETAIL

New Accessories

Burnt-Dead 19" G. Fir S 89° E 18.7 FT 3"
PK RIGHT Side Center No BLAZE or Scribe

Burnt-Dead 20" G. Fir S 27° E 9.5 FT 3"
PK Right Side Center No BLAZE or Scribe

Sketch of Monument, Accessories, and General Area


Location & Comments

Lat. 43° 19' 15.55" N.
Long 122° 52' 24.56" W
See Attached Sheet for
Sketch

CORNER IS ON
FIRE BENCH

Area BURNED
9-2020

Comp. Decline. 14 1/2° E
Agency DCSO
Party Chief S. Klause
Note keeper
Witnesses J. Lorusong

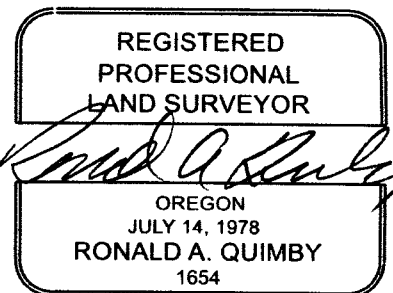


EXPIRES: 12/31/2022

CS 67/52-34
2/4

T26S, R02W, 700536

4/21/22

W 1/4 507 ONLY
T26S, R01W 700540

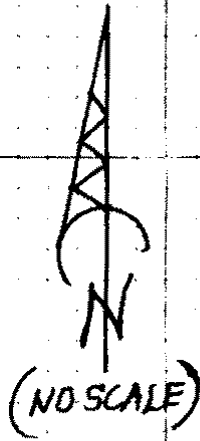

1910 O.B.T.
VERY BURNED
20" X 5 1/2 FT.
CHINQUAPIN STUMP

N28°E, 472 FT.

NEW BT
BURNED DEAD
19" G. FIR

B.C. S89°E, 182'

S87 3/4°E
392'

1961 DCSO BT
BURNED DEAD
12" CEDAR

NEW BT.
BURNED DEAD
20" G. FIR
S27°E, 95'

DECLINATION 14 1/2°E

CS 67/52-34

3/4

MM GPS 4/21/22
TIME - 8:40
H. 26 - 1.682M

4/21/22

TOWNSHIP 26 RANGE 02 POINT IDENTIFIER # 700536

PRIMARY CORNER DESCRIPTION W. 1/4 Cor. for Sec. 7 only, T26-1

Alias _____	Description _____
Alias _____	Description _____
Alias _____	Description _____
Alias _____	Description _____

GLO survey by Fred Mensch, Deputy Surveyor, under Contract #797, dated April 19, 1910 - (DCSO records Vol. 10 Page(s) 4166)

I establish 1/4 sec. cor. on W. bdy. of sec. 7, as follows:
 Set a basalt stone 16x12x10 ins., 11" in the ground for 1/4 sec. cor. marked 1/4 on E. face, from which
 A Chinquapin 15" dia., bears N.28°E., 73 lks. dist. mkd. 1/4 S7 BT.
 A Madrone 5" dia., bears S.69°E., 43 lks. dist. mkd. 1/4 S7 BT.

Fd. and used in GLO survey by C.M. Collier, Deputy Surveyor, under Instructions dated May/Sept. 1913 - (DCSO records Vol. 10 Page(s) 4265)

Douglas Co. Surveyors Office - Milo Godfrey, Deputy and Clete Putnam, crew - April 17, 1961 - C.S. File 52/77-2

Found - Mound of rocks. No markings found on any rock, crumbly.
 Chinquapin, now 18", N.28°E., 48.2 ft. Tree has been chopped open, scribing "S7 BT" visible. Tree in good condition.
 Madrone, down and badly rotted, S.69°E., 28.4 ft. No scribing.
 Set Iron pipe with brass cap mkd. County Surveyors Office
 T 26 S
 | W 1/4 S7 R1W
 1961
 New BT - 6" I.Cedar S.87°E., 39.3 ft. mkd. 1/4 S7 CS BT. WE ADD ROUGH MOUND OF STONE AROUND MON.

Fd. OK. and used in BLM Resurvey by Lynn M. Roseberry, Cadastral Surveyor, under Group #664, Surveyed April 1968 - (DCSO records Vol. 34 Page(s) 14269)

Ken Hoffine - For: Lone Rock Timber Management Co. - July 2010 - M161-10

Found - 1961 Douglas County brass cap
 26" Chinquapin bears N.28°E., 47.9 ft (record 20" x 5 1/2 FT. N.28°E., 48.2 ft) healed face and tag.
 12" x 13" cedar bears S.87°E., 39.3 ft as per Garrett map M47-7 (could not measure from corner, as BT is behind standing timber) healed face and tag.
 Corner lies 4.09 ft westerly of section line record 4.14 ft corner lies on flat bench. DECLINATION 14 1/2°E

VERY BURNED TALL STAMP
BURNED DEAD 12" x 13" NOW BEHIND OTHER TREES BUT DID OFFSET MEAS.

DUE TO CONDITION OF FOUND BT'S NO RSC PK'S ADDED

NEW REFS

BURNED DEAD 19" G. FIR NO BLZ OR SCRIB
" " 20" G. FIR " "

S89°E, 18 I 3" PK, RSC
S27°E, 95 " CS 67 | 52-34
414