

GOVERNMENT CORNER RESTORATION FORM

FILED

TOWNSHIP 25S RANGE 3W SEC. 20 PLSS # 300300

Date: 7/20/2022 By: X
This survey consists of:

DOUGLAS COUNTY OREGON

DATE 4-25-22

Map: _____

Narrative: _____

Corner Rpt: CS 67/52-35

Corner Designation

DOUGLAS COUNTY
SURVEYOR

sec Cor $\frac{20}{29} | \frac{21}{28}$

Monument(s) Found: (Condition and Source)

Condition report

Not Found

Renewed

Unrecorded

Surveyed In

2 1/2" GLD BRASS CAP ON 1 3/4"

ID PIPE PROJ 13"

Previous Renewals

GLD Resurvey 1940 Vol 27 pgs

11578-79

DCSO 1966 CS 54/27-28

Quimby 2007 CS 65/60-20

Quimby 2015 M 146-32

Quimby 2020 CS 65/106-62

MONUMENT DETAIL

US GENERAL LAND
OFFICE

T25S R3W

$\frac{520}{529} | \frac{521}{528}$

1943

Accessories Found

20" X 1 FT BURNT SAWN Hemlock STUMP S90E

25.5 FT

BURNT-DEAD 12" FIR S74°W 6.4 FT (REC 6.0 FT)

Healed SCAR

17" Hemlock N42°W 3.5 FT Healed SCAR

Singed

Steel Fence Post SSE 2.5 FT FROM

BRASS CAP

RENEWAL

Monument Set (Procedure and Description)

MONUMENT DETAIL

New Accessories

Burnt - SAWN 19" X 1 1/2 FT D. FIR STUMP
N 12° E 8.4 FT PK TOP CENTER

ADD 3" PK'S TO RIGHT SIDE CENTER OF
BEARING TREES

Sketch of Monument, Accessories, and General Area


Location & Comments

LAT 43° 22' 42.16" N
LONG 123° 04' 09.90" W

see attached sheet for
sketch

AREA BURNT
9-2020

Comp. Decline 14 1/2° E
Agency DCSO
Party Chief S. Flouse
Note keeper _____
Witnesses J. LORSUNG

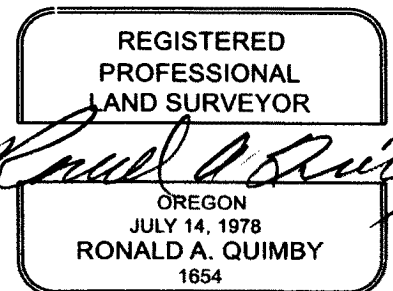

EXPIRES: 12/31/2022

CS 67/52-35
214

T25S, R03W, 300300

4/25/22

520/521

529/528

(NO SCALE)

1966 DCSO B.T.
 ALIVE 17' HEMLOCK
 N42°W, 35'

NEW REF.
 3" P.K. TOP CNTR.
 19" x 1 1/2 FT. BURNED SAWN
 D. FIR STUMP

1966 DCSO B.T.
 BURNED DEAD 12' FIR
 S74°W, 64'

B.C.

S9E 25E'

1966 DCSO B.T.
 BURNED, SAWN
 20" x 1 FT TALL
 HEMLOCK STUMP

DECLINATION 14 1/2° E

CS 67/52-35

3/4

MAN 4/25/22
TIME-11:10
H.I. - 2.000M
TOWNSHIP 25 RANGE 03 POINT IDENTIFIER # 300300

4/25/22

PRIMARY CORNER DESCRIPTION Sec. Cor. for 20, 21 28 and 29

Alias _____ Description _____
Alias _____ Description _____
Alias _____ Description _____
Alias _____ Description _____

Doug. County Surveyors Office - Vernon Tracy; Jack Heritage
July 1966 - C.S. File 54/27-28

Found - 1943 GLO brass cap mkd.
All BTs as of 1943 resurvey are gone, down or
stumps, badly burned & rotted. No scribe marks
found.

New BTs - 3" Hemlock N.42°W., 3.5 ft. mkd. S20 CS BT.
4" Hemlock S.9½°E., 25.5 ft. mkd. S28 CS BT.
4" D.Fir S.74°W., 6.0 ft. mkd. S29 CS BT.
4" D.Fir N.34°E., 25.4 ft. mkd. S21 CS BT.

Steel fence post set alongside brass cap.
Corner lies approx. 100 ft. north of corner of timber in
dense reproduction of D.Fir and Hemlock.

Fd. 4 BTs & GLO BC by Ron Quimby, 3/2007 - C.S. 65/60-20

Ron Quimby - For: Roseburg Resources - March 2015 - M166-32

Found - 1943 GLO brass cap
NO EVIDENCE 48" tall, 12" fir snag N.34°E., 25.4' healed scar
16" hemlock S.9°E., 23.5' healed scar CUT BELOW
10" fir S.74°W., 6.0' healed scar 3" PK RSC
17" 16" hemlock N.42°W., 3.5' healed scar 3" PK RSC

20" X 1 FT TALL BURNED SAW STUMP
BURNED DEAD 12"
SINGED STILL LIVING

Fd OK per rec 9/2020 R Quimby - Area burnt - C.S. 65/106-62

NEW REF.

BURNED SAW 19" X 1 1/2" D.FIR STMP 3" PK TOP CNTR. N12°E, 8 1/4 FT

FOUND MONUMENT

US GENERAL LAND OFFICE

T255 R3W

S20 | S21

S29 | S28

1943

(AS DESCRIBED)

2 1/2" BC ON 1 1/4" ID. 1/2" PROT 13"

STEEL FNC POST SSE, 2 5 FT.

DECLINATION 14 1/2°E

CS 67/62-35
415 2