

GOVERNMENT CORNER RESTORATION FORM

FILED

TOWNSHIP 25S RANGE 2W SEC. 14

PLSS # 500400

Date: 7/20/2022 By: X  
This survey consists of:

DOUGLAS COUNTY OREGON

DATE 4-27-22

Map: \_\_\_\_\_

Narrative: \_\_\_\_\_

Corner Designation

Corner Rpt: CS 67/52-37

DOUGLAS COUNTY  
SURVEYOR

Monument(s) Found: (Condition and Source)

Condition report

Not Found

Renewed

Unrecorded

Surveyed In

2 1/2" DCSD BRASS CAP

ON 1 1/2" IRON PIPE

Previous Renewals

DCSD 1948 CS 39/169 - M12-34

DCSD 1950 CS 49/102

M<sup>c</sup>Chesney 1959 CS 53/112-49

BLM Resurvey 2001-2002 Vol

54 pgs 20922-3

MONUMENT DETAIL

County Surveyors  
OFFICE

T 25S R 2W

S 15 | S 14

S 22 | S 23

1958

Accessories Found

Original B.T.'S  
Mostly burned away 10" x 7' pine snag N 39 1/4° E  
5.0 FT

Mostly burned away 16" x 10' pine snag N 35° W  
13.0 FT

BT'S By Irving  
Burnt 15" x 6' tall fir stump S 27° W 18.4 FT

BT'S By Smith & Flouse  
Burnt - SawN stump 14" x 1 1/2' tall Chingua pin  
N 80° E 33.1 FT

Mostly Burnt away 24" x 2' fir stump  
S 47 1/2° W 62.4 FT Bridge Spike is Gone

BT'S By Skeesick  
Burnt - Dead 13" fir S 13° E 90.0 FT Healed BLAZE

Burnt - Dead 7" YEW N 10 1/2° W 68.1 FT Healed BLAZE

RENEWAL

Monument Set (Procedure and Description)

MONUMENT DETAIL

New Accessories

1" x 1" Alum. post East 8.1 FT  
5/8" I. Rod in 3/4" Iron pipe S 66 1/2° W 20.2 FT  
proj 6"

5/8" Iron Rod in 3/4" Iron pipe N 12 1/2° W 31.0 FT  
proj 6"

Sketch of Monument, Accessories, and General Area


Location & Comments

CORNER IS NEAR CENTER OF  
RIDGE BEARS NNW  
LAT. 43° 23' 16.58" W  
LONG 122° 24' 49.86" W  
See Attached Sheet For  
Sketch.

Easterly Running  
Road is East 150°  
Northwesterly Running  
Road is West 105°

AREA Burnt  
9-2026

Comp. Decline. 14 1/2° E  
Agency DCSO  
Party Chief S. F. Cause  
Note keeper  
Witnesses J. LORSUNG

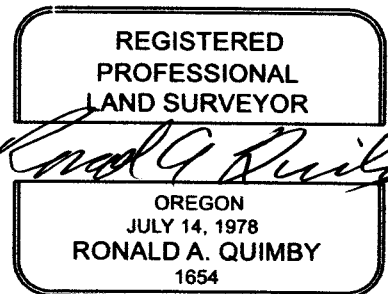

EXPIRES: 12/31/2022

CS67152-37  
214

T25S, R02W, 500400

4/27/22

S15 | S14  
522 | 523

2001/2002 BLM B.T.  
BURNED, DEAD  
7" YEW

N10 1/2° W, 68'

NEW REF  
5/8" I.R. / 3/4" I.P.

N02 1/2° W, 31'

1900 O.B.T.  
MOSTLY BURNED AWAY  
16" X 10' PINE SNAG

1900 O.B.T.  
MOSTLY BURNED AWAY  
10" X 7' PINE SNAG  
N39 1/4° E, 52 FT.

N05 1/2° W, 13'

NEW REF  
5/8" I.R. / 3/4" I.P.

S86 1/2° W, 20'

N80° E, 33'

1995 DCSO B.T.  
SAWYER BURNED  
14" X 1/2 FT. TALL  
CHINQUAPIN STUMP

B.C.

S81 1/2° W, 28'

1948 DCSO B.T.  
15" X 6 FT.  
BURNED FIR STUMP

S47 1/2° W, 62'



(NO SCALE)

1995 DCSO B.T.  
MOSTLY BURNED AWAY  
24" X 2 FT. TALL FIR STUMP

S13° E, 90'

2001/2002 BLM B.T.  
BURNED, DEAD  
13" FIR

DECLINATION 14 1/2° E

CS 67/52-37  
316

4/27/22

TOWNSHIP 25 RANGE 02 POINT IDENTIFIER # 500400

PRIMARY CORNER DESCRIPTION Cor. Secs. 14, 15, 22, & 23

Alias _____	Description _____
Alias _____	Description _____
Alias _____	Description _____
Alias _____	Description _____

FD. BC & 4 BTs by Glen McChesney, Wey Co. - 8/17/1959 - C.S. File 53/112-49 - Added "W" nails & plates to BTs

Douglas County Surveyors Office - Randall Smith & Stephen Flause - 3/29/95 - C.S. 64/58-12

Found - 2 1/2" DCSO Brass cap on a 1 1/2" Iron pipe leaning 9" NW of plumb (marks on brass cap are orientated east)

8" now 26" dia, 45' high pine snag with a fully healed double blaze, bears N.38°E., 5' (rec. N.46°E., 4', could be a face meas.)

7" now 39" dia, 50' high pine snag with a previously opened burnt blaze, no scribing visible lower blaze is fully healed, bears N.35°W., 13' (rec N.35°W., 11.9', dist could be a face meas.)

No other orig BT's Found

8" now down and rotted hemlock of indeterminable size, roothole falls near rec bearing & dist. (rec S.83°E., 38.3')

16" now 22" dia, 6' high pine stump with a fully healed double blaze, bears S.29°W., 18.4'.

New - BC/IP is returned to plumb position, protrudes 3" above ground. Marks on top of BC are orientated east.

9" dia, chinquapin, double blazed and scribed "T25SR2WS14CSBT", bears N.80°E., 33.1'.

Boat spike through BT tag, top Stamped "DCSO B01 1995", in top center 36" dia. 2' high pine stump. Boat spike, bears S.47 1/2°W. 62.4'.

BLM resurvey by A. Bert Skeesick, Cadastral Surveyor under Group #1979, surveyed May 2001/June 2002- (DCSO rec. Vol. 54 Page(s) 20922-3)

The cor. of secs. 14, 15, 22, and 23, perpetuated by Irving, in 1948, perpetuated by Byron, in 1958, perpetuated by Smith and Flause, in 1995, monumented with an iron post, 1 1/2" dia., firmly set, projecting 2" above ground, with brass cap (properly) mkd.

from which the remains of the original bearing trees

pine snag, 29" dia., bears N.39 1/2°E., 5.0 ft., with healed blaze. (Record, N.46°E., 4.0 ft.)

pine snag, 34" dia., bears N.35°W., 13.0 ft., with a burnt out blaze. (Record, 11.9 ft.)

and remains of a bearing tree mkd. by Irving

A fir stump, 24" dia., bears S.27°W., 18 1/4 ft., with healed blaze

continued next page

MOSTLY BURNED AWAY  
10" X 7 FT SNAG

MOSTLY BURNED AWAY  
16" X 10 FT SNAG

BURNED STUMP  
15" X 6 FT FALL

BLAZE GONE

2 1/2" BC PROPERLY MKD.  
PROT. 2"  
BURNED OFF  
ALUM. ANGLE LAT.  
NORTH, 0 1/4 FT

OVER ->



PRIMARY CORNER DESCRIPTION Cor. Secs. 14, 15, 22, & 23

Alias _____	Description _____
Alias _____	Description _____
Alias _____	Description _____
Alias _____	Description _____

GLO Survey by Hezekiah H. Johnson, under Contract #721, dated May 1, 1900 (DCSO records Vol. 9 Page(s) 3608)

-----

A point about 200 ft. above brook on summit of ridge - bearing E and W.  
 Set a chinquapin post 3 ft. long, 4" sq., 24" in the ground for cor. of sacs. 14, 15, 22 & 23 marked T25S S14 on NE, R2W S23 on SE., S22 on SW. and S15 on NW faces with 3 notches on S and 2 notches on E edges, from which

- A pine, 8" dia., bears N.46°E., 6 lks. mkd T25S R2W S14 BT
- A hemlock, 6" dia., bears S.67°E., 31 lks., mkd T25S R2W S23 BT.
- A hemlock, 8" dia., bears S.51°W., 22 lks., mkd T25S R2W S22 BT.
- A pine, 7" dia., bears N.35°W., 18 lks. mkd T25S S2W S15 BT

Douglas Co. Surveyors Office - B.B. Irving, Co. Surveyor - A.R. Evans, Deputy - Wit: Milo Godfrey, Les Kershner, Clinton - Feb. 1948 - C.S. File 39/169 & M 12-34

-----

Identified from OBTs

- Set - 4"x4"x60" fir post
- Remarked OBT - 18" Pine, N.46°E., 6 lks.
- 24" Pine, N.35°W., 18 lks.
- New - 8" Hemlock S.83°E., 38.3 ft.
- 16" Pine, S.29°W., 18.4 ft.

Douglas Co. Surveyors Office - James Byron, Deputy - M. Godfrey & S. Bilow - July 14, 1958 - C.S. File 49/102

-----

Found - Scribed Wooden stake, probably set by B. Irving 1948  
 All trees mentioned by Irving:

- 18" Pine, now N.46°E. 4 ft., lower scar grown over. Upper scar partially grown over & pitched over, no scribing visible.
- 24" Pine, now 28" N.35°W. 11.9 ft. lower scar grown over. Upper Scar nearly grown over, traces of scribing visible.
- 8" Hemlock, now 10" S.83°E. 38.3 ft. Both scars open. Scribing visible "T25S R2W S14 CS BT"
- 16" Pine, now 19" S.29°W., 18.4 ft., lower scar grown over. Upper blaze badly pitched over, traces of scribing visible.
- 11" Hemlock Snag scribed "25S R2W S23" bears S.66°E. 20.2 ft.

At Corner Set I P w/Brass Cap Mkd: "County Surveyor's Office, 1958 T25S R2S S15/S14  
S22/S23 continued next page