

GOVERNMENT CORNER RESTORATION FORM

FILED

TOWNSHIP 24S RANGE 2W SEC. 34 PLSS # 500100

Date: 7/20/2022 By: K
This survey consists of:

DOUGLAS COUNTY OREGON

DATE 5/25/22

Map: _____

Narrative: _____

Corner Rpt: CS 67/52-40

Corner Designation T24S R2W

DOUGLAS COUNTY
SURVEYOR

See Cor. 534/535
53/52 T25S

Monument(s) Found: (Condition and Source)

___ Condition report

___ Not Found

Renewed

___ Unrecorded

___ Surveyed In

2 1/2" GALD BRASS CAP

ON 1 3/4" I.D Iron Pipe

Projecting 12"

Previous Renewals

BLM Resurvey 1951-1963

Vol 32 pgs 13278-79

Quimby 2015 CS 65/89-2

MONUMENT DETAIL

T24S R2W

534/535

53/52

T25S

1951

Accessories Found

BLM BEARING TREES

Burnt-Sawn 30" X 3FT CEDAR STUMP N 45 1/2° E

60.7 FT GOOD SCAR

Burnt 40" CEDAR S 38° E 21.4 FT (Rec 21.1 FT)

ADD 3 1/2" P.K NAIL RIGHT SIDE CENTER

Burnt Broken 40" X 10' CEDAR SNAG S 46 1/2° W

23.4 FT (Rec S 46° W 23.8 FT)

Burnt 32" CEDAR N 57° W 50.8 FT GOOD SCAR

N.E COR. TRACT 38 BEARS N 16° E 29.9 FT

RENEWAL

Monument Set (Procedure and Description)

MONUMENT DETAIL

New Accessories

Burnt 20" Hemlock N 86° E 9.2 FT
3 1/2" P.K. RIGHT SIDE CENTER NOT BLAZED OR
Scribed

Metal LATH SSE 1 1/2 FT

HAND Held Lat & Long
Lat 43° 26' 20.9" N
Long 122° 55' 9.36 W

Sketch of Monument, Accessories, and General Area

Location & Comments

GPS LOCATION FOR
SDD100 IS FROM SDD101
N 16° E 29.9 FT

For sketch see
Attached sheet

AREA BURNED
9-2020

Comp. Decline. 19 1/2° E
Agency DCSO
Party Chief S. Flouse
Note keeper
Witnesses J. LORSONG



CS 67/52-40
214


T24S, R02W, 500100

MAY 25, 2022

T24S
S34 | S35
S3 | S2
T25S



(NO SCALE)

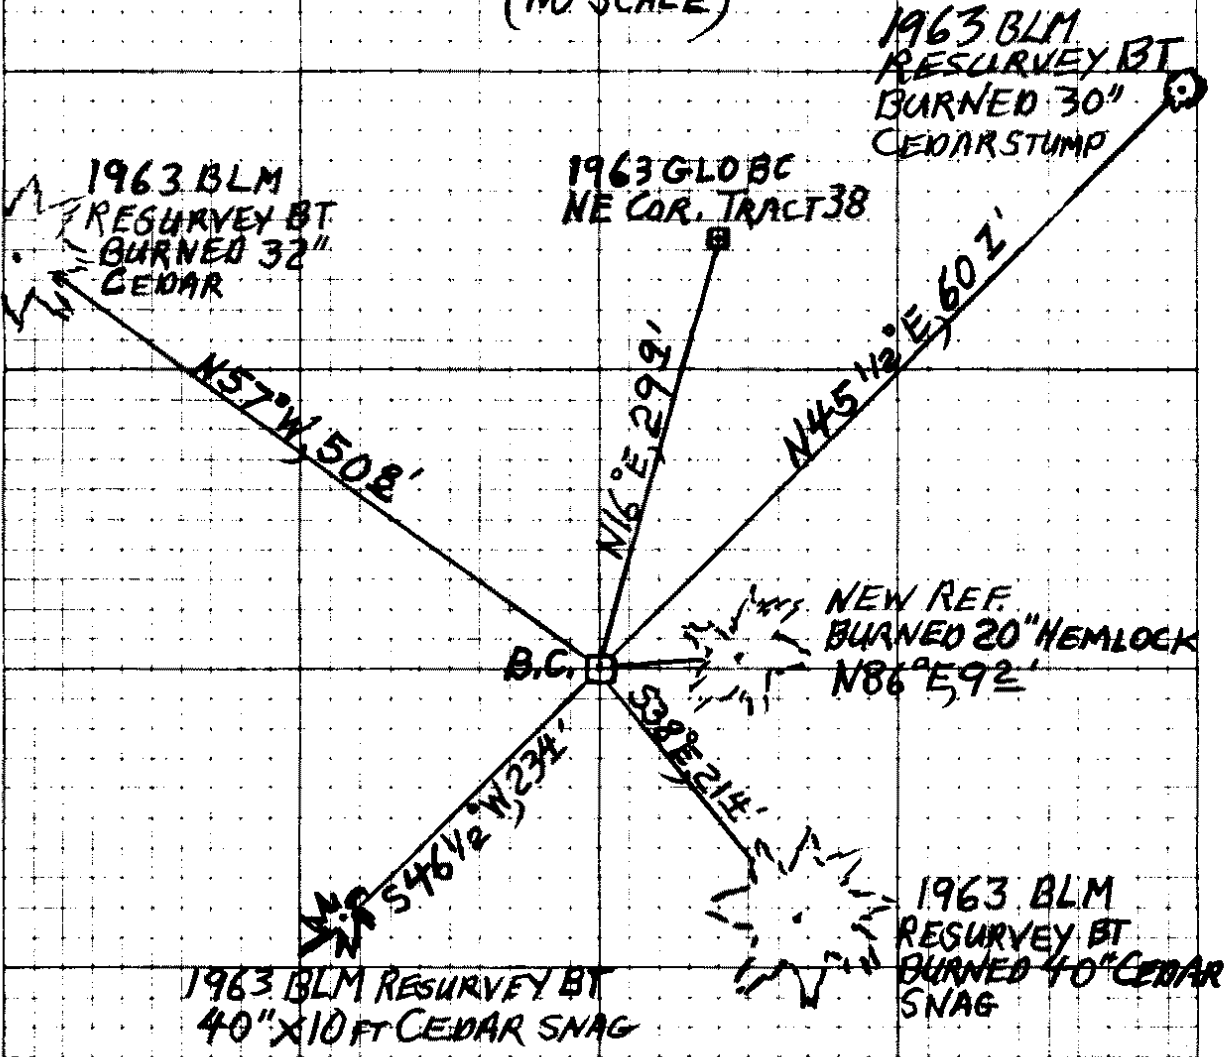

DECLINATION $14\frac{1}{2}^{\circ}E$

CS 67/52-40
3/4

5/25/22

TOWNSHIP 24 RANGE 02 POINT IDENTIFIER # 500100

PRIMARY CORNER DESCRIPTION Sec Cor. for 34 & 35: 2 & 3, T25-2

Alias _____	Description _____
Alias _____	Description _____
Alias _____	Description _____
Alias _____	Description _____

A Cedar 35" dia., bears S.46 $\frac{1}{4}$ °W., 36 lks. dist. mkd. T25S
 R2W S3 BT. (1963 BT)
 A Cedar 18" dia., bears N.57°W., 77 lks. dist. mkd. T24S
 R2W S34 BT. (1951 BT)

Ron Quimby - Crew: N. Fromdahl & R. Olsen - 5/2015 - C.S.
 File 65/89-2
 2 1/2 BG ON 1 3/4 I.D.I.P. PROT. 12"
 Found - GLO brass cap (properly mkd)
 BURNED SAW 30" X 3 FT. STUMP 29" Cedar N.48 $\frac{1}{2}$ °E., 60 $\frac{1}{2}$ ft. good scar.
 BURNED DEAD 40" Cedar S.38°E., 21.1 ft. good scar. 21 $\frac{1}{4}$ ADD 3 1/2 PK RSC
 BURNED DEAD BROKEN 40" X 10" SWAG 31" Cedar S.46°W., (rec. 46 $\frac{1}{4}$) 23.8 ft. good scar. 54 1/2 W 23 $\frac{1}{4}$
 BURNED DEAD 32" 31" Cedar N.50°W., 50.8 ft. good scar.
 New - NE corner Tract 38 bears N.16°E., 29 $\frac{1}{2}$ ft.
 Note - Hand held Lat: 43°26.209 Long: 122°55.936
 Compass decl. 15 $\frac{1}{2}$ °E.
 NEW REFS COMPASS DEC 14 1/2 °E

BURNED DEAD 20" HEMLOCK NOT BLTD OR SCRB. N86°E 9 $\frac{1}{2}$ 3 1/2 PK RSC
 GPS POSITION IS FOR 500100 \approx N16°E, 29 $\frac{1}{2}$ FT. TO 500101
 METAL LATH \approx SSE, 1 1/2 FT.

CS 67/52-40
4/4