

GOVERNMENT CORNER RESTORATION FORM

FILED

TOWNSHIP 24S RANGE 2W SEC. 38 PLSS # 500100

Date: 7/20/2022 By: X  
This survey consists of:

DOUGLAS COUNTY OREGON

DATE 5-25-22

Map: \_\_\_\_\_  
Narrative: \_\_\_\_\_  
Corner Rpt: CS 67/52-41

Corner Designation

NE COR TRACT 38 S34/S35  
TR38/ TR39

DOUGLAS COUNTY  
SURVEYOR

Monument(s) Found: (Condition and Source)

\_\_\_ Condition report

2 1/2" GLD BRASS CAP ON

\_\_\_ Not Found

1 3/4" I.D IRON PIPE

Renewed

Projecting 10"

\_\_\_ Unrecorded

Previous Renewals

\_\_\_ Surveyed In

BLM RESURVEY 1951-1963

VOL 32 PG 13292

Quimby 2015 CS 65/89-4

MONUMENT DETAIL

T 24S R 2W

S34 | S35

TR38 | T39

1963

Accessories Found

BT'S BY QUIMBY

Burnt 14" Hemlock N43°E 9.8 FT (Rec 9.6 FT)

ADD 3 1/2" PK RIGHT SIDE Center P.H.S.B.

Burnt 15" Hemlock S56°E 20.4 FT P.H.S.B

Burnt 7" Cedar S65°W 27.8 FT (Rec S64°W

28.4 FT) FAC GONE 3 1/2" PK RIGHT SIDE

Center  
Sec. Cor 34-35-2-3 bears S12°W 29.9 FT

RENEWAL

Monument Set (Procedure and Description)

MONUMENT DETAIL

New Accessories

Burnt 19" Hemlock S20°E 31.5 FT 3 1/2"  
PK RT side Center No BLAZE OR  
Scribe  
Metal Cath on Northerly Edge

Sketch of Monument, Accessories, and General Area

Location & Comments

For sketch see  
Attached sheet  
LAT 43°26'12.45"N  
Long 122°54'50.53"W

280 FT ± From  
Landing @ END  
of Spur Road  
AREA Burnt  
9-2020

Comp. Decline. 14 1/2° E  
Agency DCSD  
Party Chief S. F.ause  
Note keeper  
Witnesses J. Loring




CO 67/52-41  
2/4


T24S, R02W, 500101

MAY 25, 2022

NE COR TRACT 38  
SECTION 34

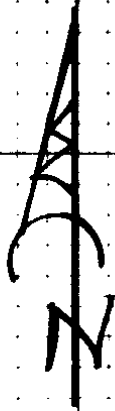

(NO SCALE)

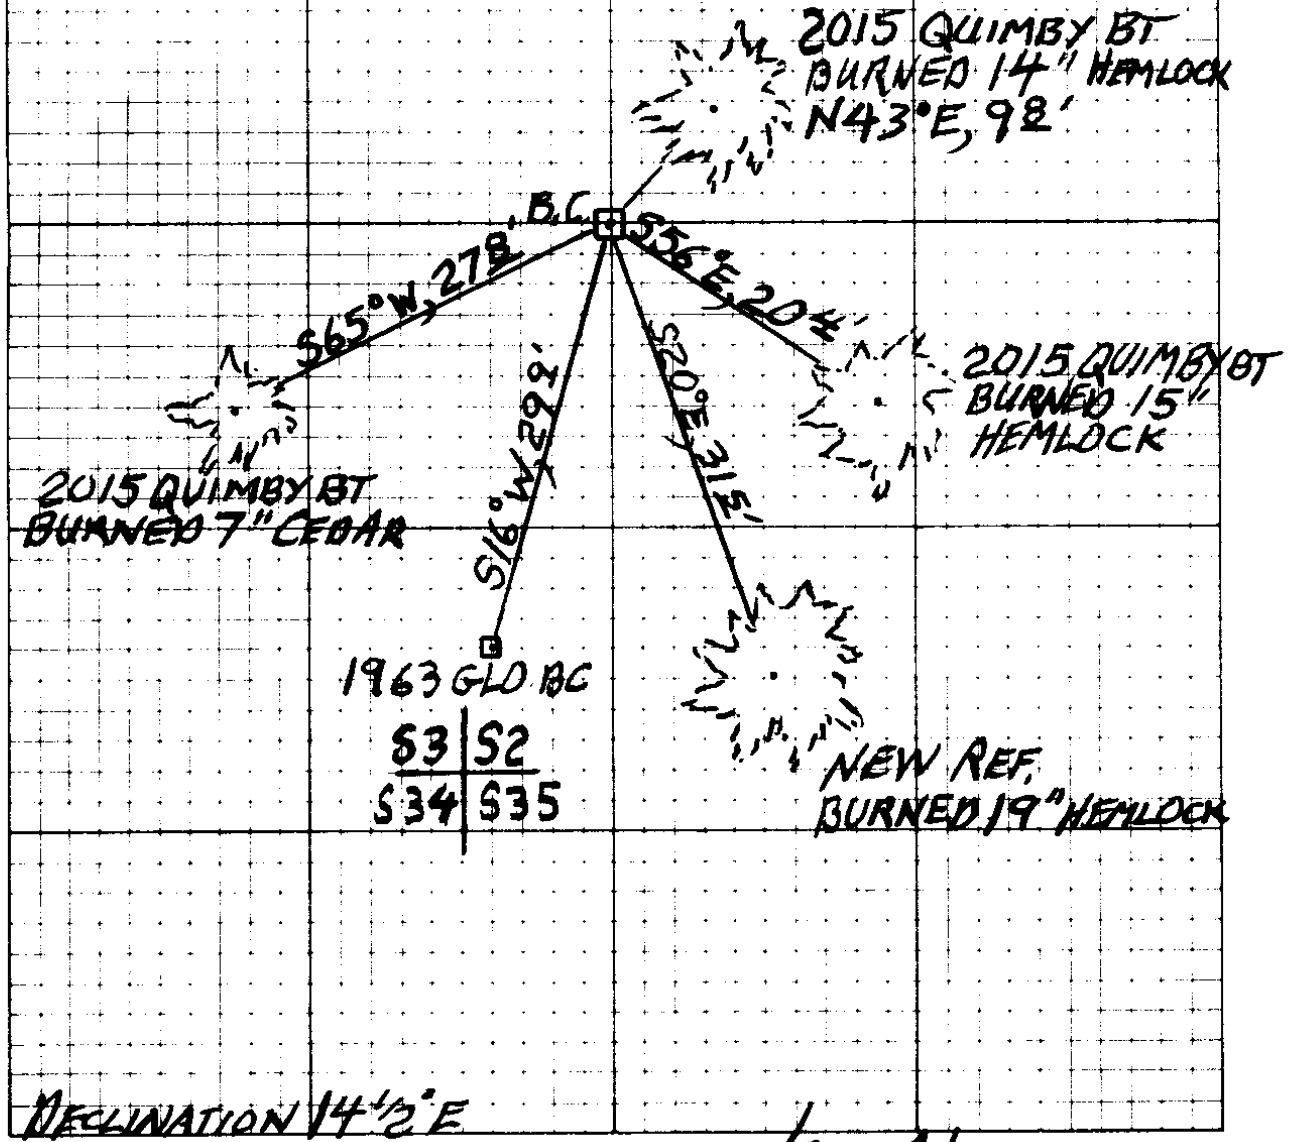

S3	S2
S34	S35

DECLINATION 14 1/2° E

CS 67/52-41

3/4

MM GPS 5/25/22  
TIME - 10:15  
H.I. - 2.000M

5/25/22

TOWNSHIP 24 RANGE 02 POINT IDENTIFIER # 500101

PRIMARY CORNER DESCRIPTION NE Cor. Tract # 38 (Sec. 34)

Alias _____	Description _____
Alias _____	Description _____
Alias _____	Description _____
Alias _____	Description _____

BLM dependent resurvey Levi E Tallett, Cadastral Engineer (1951) and C. Albert White, Cadastral Surveyor (1963), under Group # 294, surveyed May 1951 - Aug 1963 - (DCSO records Vol. 32 Page(s) 13292)

Point for the NE cor. of Tract No. 38, Sec. 34  
Set an iron post, 36" long, 2" dia., 28" in the ground, with brass cap marked:

T 24 S	R 2 W
S 34	S 35
TR 38	TR 39
1963	

from which  
A hemlock, 12" dia., bears N.3¼°E., 86 lks., mkd: S34 BT.  
A hemlock, 9" dia. bears S.65½°W. 58 lks. mkd: TR38 S34 BT

Ron Quimby - Crew: N. Fromdahl & R. Olsen - 5/2015 - C.S.  
File 65/89-4

*2 1/2" BC ON 3/4" I.D. I.P. PROT 10"*

*ADD 3 1/2" PK RSC*

*BURNED DEAD 14"* GLO brass cap (properly mkd)  
*BURNED DEAD 15"* 11" hemlock N.49°E., 9.8 ft. scribed T24S R2W S35 BT  
*BURNED DEAD 7"* 13" hemlock S.56°E. 20.4 ft scribed T24S R2W TR 39BT  
*BURNED FALLEN OUT OF POS. 6"* Cedar S.64°W., 28.4 ft scribed T24S R2W T38 BT  
*NOT GOOD ROOT HOLE* 5" Hemlock N.64°W., 6.3 ft. scribed T24S R2W S34 BT

*TO BT'S  
PASS SOME  
FACE GOLF  
"*

Note - Corner is on North facing slope 900± south of road AND  
Hand held *≈ 280 FT. NW FROM END OF SPUR RD. LANDING.*  
Lat: 43°26.212 Long: 122°54.840  
Compass decl. 15½°E.

*NEW REFS*  
*BURNED DEAD 19" HEMLOCK NO BLZ OR SCRIB 3 1/2" PK RSC, S20°E, 31 1/2 FT*  
*METAL LATR ON NORTHERLY EDGE OF BC MON.*

*DECLINATION 14 1/2°E*