

GOVERNMENT CORNER RESTORATION FORM

FILED

TOWNSHIP 26S RANGE 2W SEC. 17 PLSS # 260440

Date: 8/11/2022 By: JC  
This survey consists of:

DOUGLAS COUNTY OREGON

DATE 5/9/22

Map: \_\_\_\_\_  
Narrative: \_\_\_\_\_  
Corner Rpt: CS 67/52-46

Corner Designation

CE 1/16 S17

DOUGLAS COUNTY  
SURVEYOR

Monument(s) Found: (Condition and Source)

3 1/4" BRASS CAP ON  
2 1/4" Iron pipe in Rough  
MOUND OF Stone Proj 4"

- Condition report
- Not Found
- Renewed
- Unrecorded
- Surveyed In

Previous Renewals

B2 m Resurvey 1959  
Vol 30 pg 12758 COR. SBT  
DCSD 1992 CS 64/26-14

MONUMENT DETAIL

C E 1/16 C  
S17  
1959

Accessories Found

10" X 6' FIR SWAG N 80 1/2 W 22.9 FT mostly  
Burnt away  
20" D. FIR S 46 W 7.4 FT Healed Double  
BLAZE Tree Singed by Fire  
15" Maple N 44 1/2 W 18.5 FT Healed Double  
BLAZE Singed by Fire  
29" I. Cedar S 18 1/2 E 47.0 FT Healed  
Double BLAZE SLIGHT Burn Bark at Base

ADD 3 1/2" P.K.S TO RIGHT SIDE  
Center of FD BEARING trees

Monument Set (Procedure and Description)

MONUMENT DETAIL

---



---



New Accessories

---



---




---

Sketch of Monument, Accessories, and General Area

LAT 43°18'21.17" N  
 LONG. 122°57'24.73" W  
 See Attached Sheet  
 For Sketch

Location & Comments

Stream Now  
 50' ± North  
 Area Burnt  
 9-2020  
 Comp. Decline. 14 1/2° E  
 Agency DCSD  
 Party Chief S FIAUSE  
 Note keeper  
 Witnesses J LORSUNG

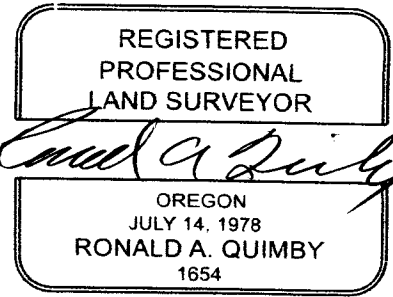

EXPIRES: 12/31/2022

CS 67/52-46

2/4

T265, R02W, 260440

5/9/22

CE 1/16 S 17

1992 DCSO BT  
15" MAPLE  
N44 1/2° W, 18 1/2'


OLD STREAM BANK

1959 BLM BT  
10" X 6 FT FIR SNAG  
N80 1/2° W, 22 1/2'

B.C.

1992 DCSO BT  
20" D. FIR  
S46° W, 7 1/2'

S18 1/2° E, 67 1/2'

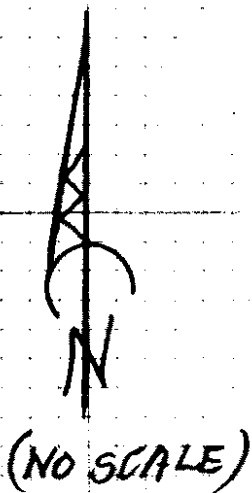

1992 DCSO BT  
29" L. CEDAR

DECLINATION 14 1/2° E

CS 67/52 ÷ 46

314

CND/RL  
2022-05-09  
10:00 AM

MM GRS 5/9/22  
TIME - 10:00  
H.I. - 2.000

HONEY CRK # 138

5/9/22

TOWNSHIP 26 RANGE 02 POINT IDENTIFIER # 260440

PRIMARY CORNER DESCRIPTION Center East 1/16 Sec. 17

Alias _____	Description _____
Alias _____	Description _____
Alias _____	Description _____
Alias _____	Description _____

BLM dependent resurvey by Irving Zirpel, Jr. & Wm. Glenn, Cadastral Surveyors, Group No. 404, surveyed May/Oct. 1959 - (DCSO Vol. 30 Page(s) 12758)

Point for the center E 1/16 sec. cor, of sec. 17.  
Set an iron post. 28" long, 2 1/2" dia., 24" in the ground, and in a mound of stone, 2 ft. base, to top, with brass cap mkd.

3 1/4" BC C E 1/16 S 17 C 1959 IN ROUGH MOUND OF STONE  
PROT 4 INS

from which  
A fir, 11" dia., bears N.80 1/2° W., 36 lks., mkd. C E 1/16 S17 BT.  
A fir, 11" dia., bears S.2 1/4° E., 20 lks., mid. C E 1/16 S17 BT.

From this point the NE. cor, of a wood frame lean-to, bears N.75°46'E., 510 lks., dimensions 18 x 12 ft., longside bears S.45°W.

From the same point the SE. cor, of a wood frame dwelling, an old logging camp building, unoccupied, bears N.80°14'E., 561 lks., dimensions 50 1/2 x 20 ft., longside bears N.50°E.

From the same point the NE. cor. of a wood frame building, bears N.86°02'E., 505 lks., dimensions 64 1/2 x 23 ft., longside bears S.50°E. Cor. falls at foot of descent, slopes N.; asc. 8 ft. over NE. slope.

Douglas Co. Surveyors Office - Randall W. Smith - Stephen J. Flause - June 8, 1992 - C.S. File 64/26-14

Found - 3" BLM brass cap on a 2 1/2" O.D. iron pipe protruding 2" above a 2 ft. dia. mound of stone. Cap is marked: "U.S. Cadastral Survey C E 1/16 1959 Bureau of Land Management"

SEE ABOVE

11" now 16" dia. D.Fir with a fully healed single BLAZE SCAR blaze, bears N.80 1/2° W., 22.9 ft. (rec. N.80 1/2° W., 23.8 ft. to center of trunk 1959 survey)

11" now 17" dia. 3 ft. high D.Fir stump with a fully healed single blaze, bears S.2 1/4° E., 13.2 ft. (agrees with rec. 1959 survey)

20" 7" dia. D.Fir double blazed & scribed "CE 1/16 S17 HEALED DOUBLE BLAZE CS BT" bears S.46° W., 7.4 ft.

15" 13" dia. Maple, double blazed & scribed CE 1/16 S17 CS BT" bears N.44 1/2° W., 18.5 ft to center of trunk

29" 11" dia. I.Cedar, double blazed & scribed "CE 1/16 S17 CS BT" bears S.18 1/2° E., 67.0 ft.

Note - Corner lies 5 ft. south of creek bank. ADD 3 1/2" PK TO RSC OF FOUND BTS  
ACTUAL STREAM NOW FLOWS ~ 50 FT. NORTH

10x6 FT SNAG MOSTLY BURNED AWAY BURNED TO GROUND

SINGED BUT ALIVE - 20" 7"

SLIGHT BURN BASE BARK

DECLINATION 14 1/2° E

CS 67/52-46 1