

GOVERNMENT CORNER RESTORATION FORM

TOWNSHIP 24S RANGE 2W SEC. 35 PLSS # 500119

FILED  
Date: 8/11/2022 By: X  
This survey consists of:

DOUGLAS COUNTY OREGON

DATE 6-2-22

Map: \_\_\_\_\_

Narrative: \_\_\_\_\_

Corner Rpt: CS 67/54-1

Corner Designation

N.W COR. TRACT 39  
See 35

DOUGLAS COUNTY  
SURVEYOR

Monument(s) Found: (Condition and Source)

3 1/4" BLM BRASS CAP  
Proj 6"

- Condition report
- Not Found
- Renewed
- Unrecorded
- Surveyed In

Previous Renewals

BLM resurvey Set COR  
1951-1963 Vol 32 pg 13292  
DCSD 1968 CS 54/27-143  
DCSD 1981 CS 61/24-12

MONUMENT DETAIL

T 24S R 2W  
534 | 535  
TR 39  
1963

Accessories Found

DCSD 1968 BX  
Burnt - SAWN 24" X 2' D. FIR STUMP S65E  
42.0 FT (Rec S63°E 41.8 FT) To 3 1/2" PK  
NAIL Top Center  
DCSD 1981 BT'S  
30" FIR STUMP SAWN Flush with Ground  
S54°W 5.0 FT  
16" X 5 FT Rotten Broken FIR SWAG S83°W  
24.8 FT

New Accessories

BURNED DEAD 22" D. FIR N 27° E 33.0 FT  
 STAINLESS WASHER "Douglas Co. Surveyor"  
 NAILED IN FACE 3 1/2" PK NAIL RIGHT SIDE CENTER

BURNED but ALIVE 56" D. FIR N 78° E 40.5 FT  
 STAINLESS WASHER "Douglas Co. Surveyor"  
 NAILED IN FACE 3 1/2" PK NAIL RIGHT SIDE CENTER

BURNED SAWN 20" X 15" D. FIR STUMP 50 3 1/2" W  
 12.4 FT 3 1/2" PK NAIL TOP-CENTER

Sketch of Monument, Accessories, and General Area


LAT 43° 26' 21.28" N  
 LONG 122° 54' 47.10" W

FOR SKETCH SEE ATTACHED SHEET.

Location & Comments

CORNER IS APPROX  
 220' NORTH OF  
 COBBLE CREEK ACCESS  
 ROAD  
 AREA BURNED  
 9-2020

Comp. Decline. 14 1/2° E  
 Agency DCSO  
 Party Chief S F LAUSE  
 Note keeper  
 Witnesses J LORSUNG

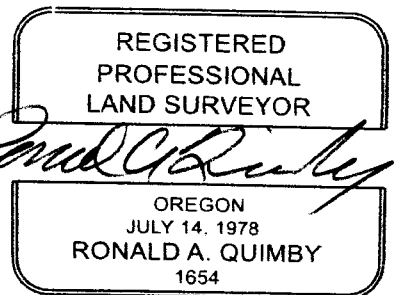


EXPIRES: 12/31/2022

CS 67/54-1<sub>2/4</sub>

T24S, R02W, 500119  
NW COR TRACT 39

JUNE 2, 2022

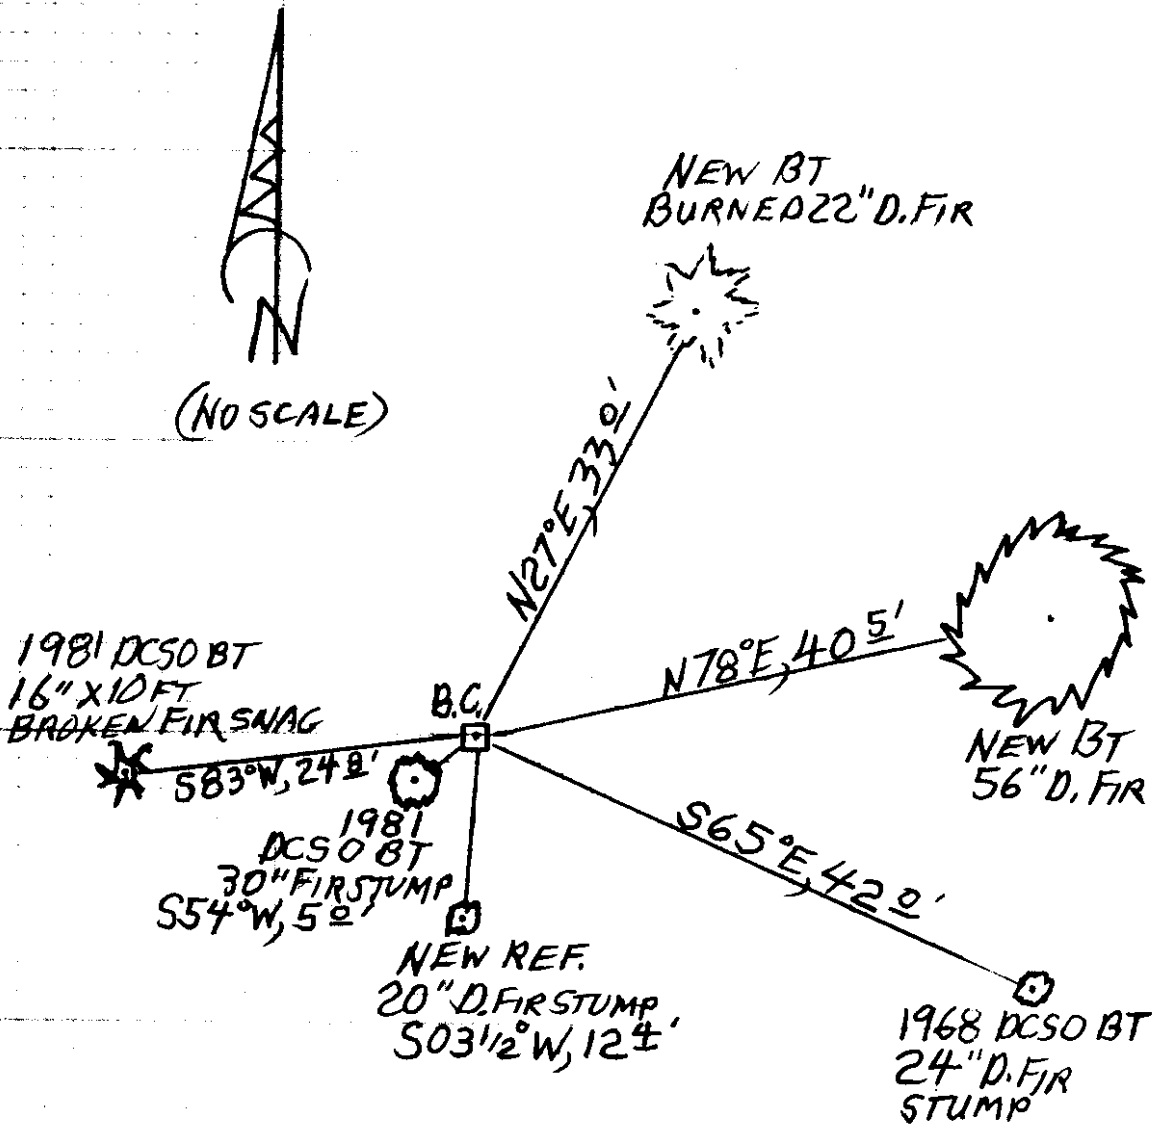

DECLINATION 14 1/2° E

CS 67/54-1  
3/4

TIME - 10:00  
H.I. - 2.000M

RENEWED 6/2/22

TOWNSHIP 24 RANGE 02 POINT IDENTIFIER # 500119

PRIMARY CORNER DESCRIPTION NW Cor. Tract No. 39 (Sec. 35)

|             |                   |
|-------------|-------------------|
| Alias _____ | Description _____ |
| Alias _____ | Description _____ |
| Alias _____ | Description _____ |
| Alias _____ | Description _____ |

BLM dependent resurvey Levi E Tallett, Cadastral Engineer (1951) and C. Albert White, Cadastral Surveyor (1963), under Group # 294, surveyed May 1951 - Aug 1963 - (DCSO records Vol. 32 Page(s) 13292)

Point for the NW cor. of Tract No. 39, Sec. 35  
Set an iron post, 36" long, 2" dia., 28" in the ground, with brass cap marked:

|  |   |    |   |      |    |   |
|--|---|----|---|------|----|---|
|  | T | 24 | S | R    | 2  | W |
|  | S | 34 |   | S    | 35 |   |
|  |   |    |   | TR   | 39 |   |
|  |   |    |   | 1963 |    |   |

from which  
A sugar pine, 9" dia., bears N.34¼°E., 53 lks. mkd: S35 BT  
A fir, 15" dia., bears S.39¼°E., 62 lks., mkd: TR39 S35 BT

Douglas Co. Surveyors Office - Vernon "Ray" Tracy - Jack Heritage - V. Perron - April 1968 - C.S. File 54/27-143

Found - Cadastral bras cap, bent over & buried. Reset in proper place from BTs as follows:  
9" now 10" Sugar Pine N.34¼°E., 35.0 ft., alive, scribe visible on partially healed blaze.  
15" Fir, now shattered stump S.39¼°E., 40.9 ft., scribe visible.

New BT - 8" D.Fir, S.63°E., 41.8.ft. mkd: TR39 S35 CS BT.  
Note - This corner lies approx. 350 ft. N of Twin Cedar Springs Road on section line between sections 34 & 35.

DECLINATION 14½° E

Douglas Co. Surveyors Office - Gregory E. Quibell, Deputy - Teresa Buley - Oct. 14, 1981 - C.S. File 61/29-12

Found 3/4" 1963 BLM brass cap, properly mkd., firmly set. PROT. 6"  
NO EVID REMAINS 9" now 14" Pine per resurvey bears N.34°E., 34.5 ft., (Rec. 35.0 ft.)

NO EVID. Rotted remains of 15" Fir per resurvey bears S.39°E., 40.9 ft.

8" now 14" D.Fir, (1968 ren.) bears S.63°E., 41.8 ft. with well healed scar.

New BTs - 6" Fir bears S.54°W., 5 ft., scribed "S34 CS BT" in bark.

ROTTEN BROKEN SNAG 16x5 FT. 11" Fir bears S.83°W., 24.8 ft., scribed "S34 CS BT" in double blaze.

Note - Corner lies north of ~~rock Rd.~~ approx. 220 ft. INCORRECT

COBBLE CRK. ACCESS RD. APPROX 220 FT.

NEW REFS  
 BURNED DEAD 22" D.FIR, STAINLESS WASHER "DOUGLAS CO. SURVEYOR" NAILED IN FACE AND 3 1/2" PK SET R.S.C. TREE BEARS N 27° E, 33° FT.  
 BURNED BUT ALIVE 56" D.FIR, MARKED AS ABOVE, TREE BEARS N 78° E, 40.5 FT.  
 BURNED SAWN D.FIR STMP 20x15 FT 3 1/2" PK TOP CNTR S 03 1/2° W, 12 1/4 FT.

BURNED SAWN 24"x2 FT STMP  
 30" SAWN FLUSH WITH GRND.  
 ROTTEN BROKEN SNAG 16x5 FT.

CS 67/54-1 414