

GOVERNMENT CORNER RESTORATION FORM

FILED

TOWNSHIP 25S RANGE 3W SEC. 3 PLSS # 5006A0

Date: 8/11/2022 By: X
This survey consists of:

DOUGLAS COUNTY OREGON

DATE 6-7-22

Map: _____

Narrative: _____

Corner Rpt: CS 67/54-3

DOUGLAS COUNTY
SURVEYOR

Corner Designation

1/4 COR 3/2

Monument(s) Found: (Condition and Source)

2 1/2" GLD BRASS CAP ON
1" IRON PIPE PROJ 10"

___ Condition report

___ Not Found

Renewed

___ Unrecorded

___ Surveyed In

Previous Renewals

GLD RESURVEY 1940 Vol 27 pg 11562-63
DCSD 1960 CS 49/78
DCSD 1966 CS 54/27-61
BLM RESURVEY Vol 48 pg 18480

MONUMENT DETAIL

1/4
S3 | S2
1944

Accessories Found

PRICE BT
mostly burnt away tipped over 25" Hemlock
SNA9 N 78°W 6.6 FT

TRACY B.T.S
1' Tall Burnt Maple stub S 21° E 17.2 FT Healed
BLAZE

17" X 1 1/2' Burnt Fir Stump S 9° W 12.5 FT
Healed BLAZE

ROGERS B.T.S
14" X 6 FT Burnt off D. Fir Stump
N 14° E 10.1 FT (Rec N 17° E 9.9 FT) 3 1/2"
PK NAIL RIGHT SIDE CENTER

12" X 6 1/2 FT Burnt - SAWN FIR STUMP
S 30° W 16.5 FT (Rec S 33° W) 3 1/2" PK NAIL
RIGHT SIDE CENTER

New Accessories

13" X 7' Burnt - SAWN D. FIR STUMP N 75° E
14.8 FT 3 1/2" PK NAIL RIGHT SIDE CENTER

16" X 1 FT Burned AND SAWN FIR STUMP
S 55° E 14.9 FT 3 1/2" PK NAIL TOP CENTER

Sketch of Monument, Accessories, and General Area

Location & Comments

Lat 43° 25' 42.87" N
Long 123° 01' 40.46" W

CORNER IS APPROX
* 35' WEST OF GRAVEL
ROAD ≈ 15' WIDE
BEARS N 30 W AND S

AREA BURNT
9-2020

Comp. Decline. 14 1/2° E

Agency DCSO


Party Chief S. FIAUSE

Note keeper

Witnesses J. LORSUNG.

CS 67/54-3
214

REGISTERED
PROFESSIONAL
LAND SURVEYOR

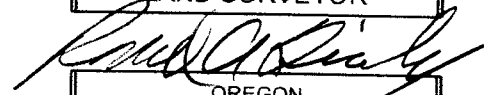

OREGON
JULY 14, 1978
RONALD A. QUIMBY
1654

EXPIRES: 12/31/2022


T25S, R03W, 500640

6/7/22

1/4
S3/S2



(NO SCALE)

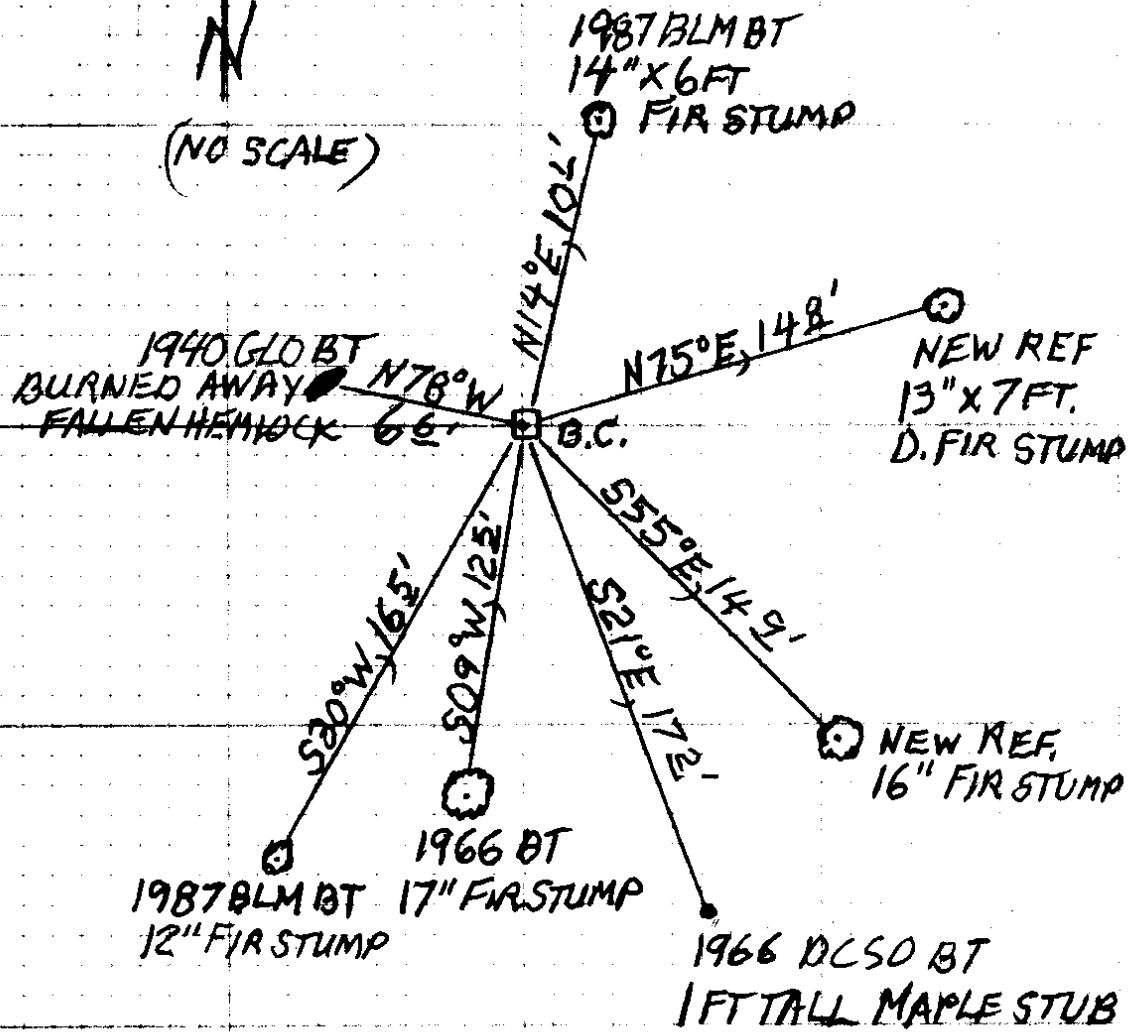

DECLINATION 14 1/2° E

CS 67/54-3

MM GPS 6/7/22

TIME - 11:30

H₁ - 2,000M

JUNE 7, 2022

TOWNSHIP 25 RANGE 03 POINT IDENTIFIER # 500640

PRIMARY CORNER DESCRIPTION 1/4 Cor. for Secs. 3 and 2

Alias _____	Description _____
Alias _____	Description _____
Alias _____	Description _____
Alias _____	Description _____

BLM Dependent Resurvey by Rogers, et al - Under Group #1386 dated June 1987 (DCSO records, Volume 48 Page 18480)

PROT. 10"

Found sec. cor. monumented with an iron post, 1" dia., firmly set, projecting ~~15"~~ above ground with a 1944 brass cap.

2 1/2" GLO B.C. MKD AS DESCRBD.

From which the remains of a bearing tree mkd. by Price: *N. 78° W., 10 6/10 kls. dist., no marks visible.*

NOW MOSTLY BURNED AWAY

And the bearing trees mkd. by Tracy in 1966:

1 FT. TALL BURNED STUB

A Maple 8" dia., bears S. 21° E., 26 kls. dist., with healed blaze.

17" x 1 1/2 FT BURNED STUMP

A Fir 15" dia. bears S. 9° W., 19 kls. dist. with healed blaze.

and new bearing trees:

14" x 6 FT. BURNED OFF STUMP

A Fir 8" dia. bears N. 17° E., 15 kls. dist., mkd. *14°* *10'*

ADD 3 1/2 PK R.S.C.

2" x 6 1/2 FT BURNED, SAWN STUMP

A Fir 10" dia. bears S. 33° W., 25 kls. dist., mkd. *30* *9 1/2* *16 50*

✓ The corner is 50 kls. west of a gravelled road, 20 kls. wide bears N. 30° W., and S.

DECLINATION 14 1/2° E

NEW REFS

13" x 7 FT. BURNED AND SAWN D. FIR STUMP N 75° E, 14 8 FT - 3 1/2 PK R.S.C.

16" x 1 FT. " " " FIR STUMP S 55° E, 14 9 FT - 3 1/2 PK TOP COR.

*CS 67/54-3
4/4*