

GOVERNMENT CORNER RESTORATION FORM

FILED

TOWNSHIP 255 RANGE 3W SEC. 3 PLSS # 400640

Date: 8/11/2022 By: JC
This survey consists of:

DOUGLAS COUNTY OREGON

DATE 6-9-22

Map: _____

Narrative: _____

Corner Rpt: CS 67/54-4

Corner Designation

DOUGLAS COUNTY
SURVEYOR

1/4 S4/S3

Monument(s) Found: (Condition and Source)

___ Condition report

DCSO BRASS CAP

___ Not Found

Proj. 12"

Renewed

Previous Renewals

___ Unrecorded

___ Surveyed In

DCSO Vol 4 pg 80 CS 35/38

GLS Resurvey 1940-1943

Vol 27 pg 11575

DCSO 1966 CS 54/27-76

BLM Resurvey 1987-1988

Vol 48 pg 18481

MONUMENT DETAIL

T 255 R 3W

1/4 S4/S3

Accessories Found

BLM 1940-1943 BT'S

Burnt - SAWN 27" X 2' D. Fir STUMP N 23° W
84.2 FT (REC 85.0 FT) BLAZE - FACE INSIDE
STUMP

DCSO 1966 BT'S

Burnt - DEAD 32" D. Fir S 89° E 32.0 FT (REC
N 86° E 35.2 FT) POSSIBLE BLAZE ADD
3 1/2" PK NAIL RIGHT SIDE CENTER

Burnt - SAWN 30" X 1 1/2' D. Fir STUMP
N 30 1/2° W 30.6 FT (REC N 28° W 30.3 FT)

BLAZE - FACE VISIBLE INSIDE STUMP ADD
3 1/2" PK NAIL TOP CENTER

Monument Set (Procedure and Description)

MONUMENT DETAIL

New Accessories

5/8" X 30" Iron Rod with yellow Plastic Cap
 Proj 4" S22°E 77.0 FT in South Shoulder
 of Gravel Road

5/8" X 30" Iron Rod with yellow plastic Cap
 Proj 4" S31°W 70.7 FT in South Shoulder
 of Gravel Road

Sketch of Monument, Accessories, and General Area

Location & Comments


LAT 43°25'42.29"N
 LONG 123°02'53.07"W

For sketch see Attached
 Sheet

CORNER IS North
OF GRAVEL ROAD

AREA Burnt
9-2020

Comp. Decline. 14'20" E
 Agency DCSD
 Party Chief S. F. AUSE
 Note keeper
 Witnesses J. LORSUNG

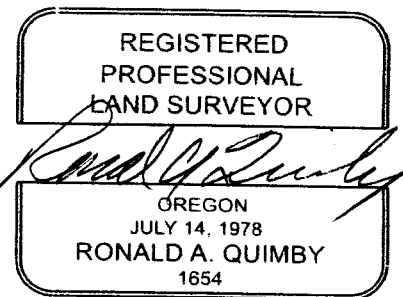

EXPIRES: 12/31/2022


CS 67/54-4
24

T25S, R03W, 400640

6/9/22

44
54 + 83

1940 GLOBT
27" X 2 FT FIR STUMP

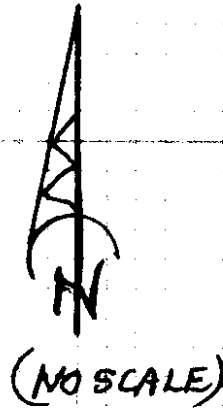

1966 DC60 BT
30" X 1 1/2' FIR STUMP
N30 1/2° W, 30 6'

B.C. 589°
32.0'

1966 BT
BURNED DEAD
32" D. FIR

53 1/4° W, 70.2'

52.2° E, 71.0'

GRAVEL RD.

NEW REF.
5/8" IR/PLSTC.
CAP

NEW REF
5/8" IR/PLSTC.
CAP

DECLINATION 14 1/2° E

CS 67/54-4
314

MM GPS 6/19/22

TIME - 9:55

H.I. - 200M

6/19/22

TOWNSHIP 25 RANGE 03 POINT IDENTIFIER # 400640

PRIMARY CORNER DESCRIPTION 1/4 Cor. for Secs. 3 & 4

Alias _____	Description _____
Alias _____	Description _____
Alias _____	Description _____
Alias _____	Description _____

Original - GLO survey by Laban H. Wheeler, under Contract #467 dated April 7, 1883 (DCSO records, Vol. 9 Page 3701)

Set Yew post, 3 ft. long, 3" sq., 24" in the ground for 1/4 sec. cor. mkd. 1/4 S on W. face, from which

A Fir 6 dia. bears N.21°E., 13 lks. dist. mkd. 1/4 S BT

A Fir 8" dia. bears N.73°W., 72 lks. dist. mkd 1/4 S BT

A. Boyer, Deputy Co. Surveyor - Wit: Ted Shellabager and Joe Murphy - April, 1940 - Vol. 4 Page 80; C.S. File 35/38

Set a Cedar post, 6" x 6" from which

A Fir 15" bears S.73°E., 15.3 ft.

A Fir 8" bears N.50°W., 25.0 ft.

GLO Dependent Resurvey by Norman D. Price under Special Instructions dated April 5, 1940 Survey, 1943 (DCSO records, Volume 27 Page 11575)

At proportional measurement, set an iron post, 3 ft. long 1" dia. 28" in the ground for 1/4 sec. cor., with brass cap mkd.

1/4
S4|S3
1943

from which

A Fir 12" dia. bears N.3°E., 91. lks. mkd. 1/4 S 3 BT.

A Fir 10" dia. bears N.23°W., 129 lks. marked 1/4 S 4 BT.

Doug. Co. Surveyors Office - Vernon Tracy; Jack Heritage Sept. 1966 - C.S. File 54/27-76

842

BURNED SAAN

Found - No trace of GLO brass cap/set in 1944 resurvey.

27" x 2" STUMP 10" now 16" Fir N.23°W., 85.0 ft., found reverse scribe previously removed from this BT., now rehealed, shows very good scar. BLZE FACE INSIDE STUMP

NO EVID. - NE BT, now stump, shows extreme bottom of scar. No scribe.

BURNED SAAN

Set brass cap at cor. mkd: PROT-12" MARKED AS DISCRIB'D

County Surveyor's T 25 S R 3 W Office, 1966

BURNED DEAN 32" S 89°E 32' 16" D Fir N 86°E., 35.2 ft. mkd: 1/4 S 3 CS BT. MOD 3 1/2 PK R-10

BURNED SAAN 30" x 1 1/2" STUMP 16" D Fir N 28°W., 30.3 ft. mkd: 1/4 S 4 CS BT. " " " TOP CNTR

30 1/2" 30 6 SEE BLZE FACE INSIDE

Found and used, Bureau of Land Management Dependent Resurvey by Rogers, Bedell and Peterson - Group #1386 - Survey June 1987-Sept. 1988 - (DCSO records, Volume 48 Page 18481)

NEW REF'S

5/8" x 30" I.R. / 1050 YELLOW PIST CAP PROT 4 SOUTH SHOULDER S 22° E, 77 0

AND GRAVEL RD. 1

531° W, 70 3

DECLINATION 14 1/2° E

CS 67/54-4
4/4