

GOVERNMENT CORNER RESTORATION FORM

TOWNSHIP 255 RANGE 1W SEC. 1 PLSS # 100547

FILED
Date: 10/18/2022 By: X
This survey consists of:

DOUGLAS COUNTY OREGON

DATE 5-16-22

Map: _____
Narrative: _____
Corner Rpt: CS 67/54-6

Corner Designation

Sec Cor 1 & 12 only T25S R2W

DOUGLAS COUNTY
SURVEYOR

Monument(s) Found: (Condition and Source)

2 1/2" GLD BRASS CAP PROJ.
15" ADDED ROUGH MOUND
OF STONE AROUND BASE

___ Condition report
___ Not Found
 Renewed
___ Unrecorded
___ Surveyed In

Previous Renewals

GLB Survey 1900 V B pg 3493 & 3498
Hosford 1949-1950 CS 40/279 M 12-61
BLM Resurvey 1951-1963 Vol 32 pg 13339
BLM Resurvey 1981 Vol 45 pg 17351
Ness 1995 M 123-3 A-B

MONUMENT DETAIL

T25S
S1
S12
R2W
T25S
R1W
S7
1951

Accessories Found

Burnt 45" x 6' RIR STUMP N25°W 73.9 FT
Healed BLAZE

2 1/2" steel CAP ON 1 1/2" I.D. IP BEAR S27°E
3.86 (Rec S29°E 4.62') FOUND BURIED TIPPED
ESE 1.8 FT Returned to plumb New proj 2"
Very burnt 15" SUGAR PINE S6°W 21.4 FT
with PARTIAL scribe visible on EXPOSED
FACE

Burnt Stump 45" x 3 1/2 FT N58°W 39.9 FT
(Rec 40.9)

Monument Set (Procedure and Description)

MONUMENT DETAIL

New Accessories

6" D. Fir N 49°E 9.8 FT scribed "X" BT
3 1/2" P.K. RIGHT side center

10" D Fir S 49°W 12.8 FT scribe "X" BT
3 1/2" P.K. RIGHT side center

Sketch of Monument, Accessories, and General Area

Location & Comments

LAT 43°25'00.18"N
LONG 122°52'26.64"W

CORNER IS approx
115' south of
GRAVEL ROAD

AREA BURNT
9-2020

FOR SKETCH SEE ATTACHED
SHEET.

Comp. Decline. 14 1/2° E
Agency DCSO
Party Chief S. FIAUSE
Note keeper
Witnesses J LORSONG

REGISTERED
PROFESSIONAL
LAND SURVEYOR

Ronald A. Quimby

OREGON
JULY 14, 1978
RONALD A. QUIMBY
1654

EXPIRES: 12/31/2022

CS67/544

T25S, R01W 100547


5/16/22

1951 BLM BT
45" x 6 FT. BURNED
FIR STUMP

N 25° W, 739'

1950 HOSFORD BT
45" x 3 1/2 FT.
BURNED FIR STUMP

N 58° W, 399'

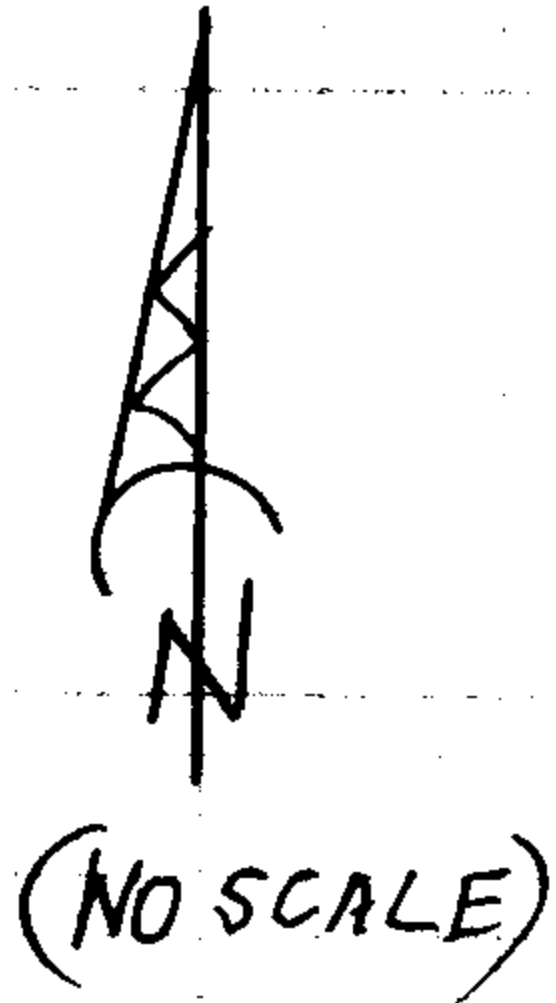

NEW BT
6" D. FIR
N 49° E, 98'

B.C.

1950 HOSFORD MON.
2 1/2" STEEL CAP ON I.P.
S 27° E, 385'

NEW BT
10" D. FIR
S 49° W, 128'

S 06° W, 215'

1950 HOSFORD BT
15" PINE SNAG BURNED

DECLINATION 14 1/2° E

LAND SURVEY

CS 67/54-6
314

MM GPS 5/11/22
TIME - 12:10
H.I. - 2.000M

RENEWED 5/16/22

TOWNSHIP 25 RANGE 01 POINT IDENTIFIER # 100547

PRIMARY CORNER DESCRIPTION Sec Cor for 1 & 12 only, T25-2

Alias _____	Description <u>PROCESSED GPS</u>
Alias _____	Description _____
Alias _____	Description <u>122° 52' 26.64" W</u>
Alias _____	Description <u>43° 25' 00.18" N</u>

BLM resurvey by Levi E. Tallett and C. Albert White, Cadastral Surveyors, under Group #294, Surveyed May 1951/Aug. 1963 - (DCSO records Vol. 32 Page(s) 13339)

Point for the cor. of secs. 1 & 12 only, at proportionate distance; there is no remaining evidence of the original corner.

Set an iron post, 36" long, 2" dia., 28" in the ground, with brass cap mkd: T 25 S

GLO 2 1/2" BRASS CAP T 25 S
 PROT 15" S 1 R 1 W
 S 12 S 7 V
 R 2 W
 1951

ADDED ROUGH MOUND OF STONE AROUND BASE OF MON.

from which

A Fir 50" dia., bears N.20°W., 112 lks. dist. mkd. T25S R2W S1 BT.

A Sugar Pine 20" dia., bears S.38°W., 50 lks. dist. mkd. T25S R2W S12 BT.

★ DECLINATION 14 1/2° E

BLM resurvey by James E. Jelley, Cadastral Surveyor, under Group #1061 - Surveyed April/June 1981 - (DCSO records Vol. 45 Page(s) 17351)

(Corner Report only) SEE ABOVE

The Sec. Cor., monumented with an iron post 2 1/2" dia., firmly set, projecting 8" above ground, with brass cap as mkd. in 1951, from which bearing trees mkd. by Whifford and Tallett:

A Sugar Pine 25" dia., bears S.38°W., 50 lks. dist., with scribe marks T25S R2W S12 BT visible on open blaze.

A Fir 48" dia., bears N.25°W., 112 lks. dist. with healed blaze. (Rec. N.20°W.)

From this point, a monument established by Hosford, in 1950, bears S.29°E., 0.07 chs. dist. monumented with an iron pipe 2" dia., firmly set, projecting 10" above ground with unmarked steel cap, from which bearing trees mkd. by Hosford:

A Sugar Pine 23" dia., bears S.6°W., 32 1/2 lks. dist., with healed double blaze.

A Fir 50" dia., bears N.58°W., 62 lks. dist., with healed double blaze.

Fd. Ok by S. Ness - M 123-3 A&B - 10/95

THESE BEADS, AS PRINTED, ARE FROM 1951 BLM MON. 3 1/2" PK RSC

NO EVIDENCE
NOW WELL DEFINED ROOTHOLE
BURNED STMP 45" X 6 FT
2 1/2" STEEL CAP
ON 1 1/2" 10.1 P
MARKED

VERY BURNED SNAG
NOW 15"
BURNED STMP
45" X 3 1/2 FT

NEW REFS

LIVE 6" D. FIR SCRIBED "X" BT BEARS N 49° E, 98

LIVE 10" D. FIR " " " BEARS S 49° W, 128

CORNER IS APPROX 115 FT SOUTH FROM GRVL. FOREST RD.

CS 67154-414