

GOVERNMENT CORNER RESTORATION FORM

FILED

TOWNSHIP 255 RANGE 1W SEC. 15 PLSS # 400440

Date: 10/18/2022 By: X
This survey consists of:

DOUGLAS COUNTY OREGON

DATE 8-16-22

Map: _____

Narrative: _____

Corner Rpt: CS 67/54-13

Corner Designation

1/4 COR 516/515

DOUGLAS COUNTY
SURVEYOR

Monument(s) Found: (Condition and Source)

2 1/2" BRASS CAP ON 1" I.D.
Iron Pipe original Stone
Alongside Cap is up 10"

___ Condition report

___ Not Found

Renewed

___ Unrecorded

___ Surveyed In

Previous Renewals

Hosford CS 51/152 & M 20-2
DCSD 1966 CS 52/30-22

MONUMENT DETAIL

County Surveyors
OFFICE
T255 RIW
1/4 516/515
1966

Accessories Found

- D. FIR S 86 1/2° E 24.2 FT REMAINS IS A
METAL RAIN CAP
Unrecorded B.T.'S POSSIBLE FOREST SERVICE
CONTRACT OCT. 2014 LS 2339 ON FOUND TAG
- 8" BURNED DEAD FIR S 24 1/2° E 6.7 FT PART.
HEALED FACE ILLEGIBLE SCRIBES ADD 3 1/2"
PK NAIL RIGHT SIDE CENTER
- 9" BURNED DEAD D. FIR S 87° W 3.4 FT PART.
HEALED FACE ILLEGIBLE SCRIBES ADD 3 1/2"
PK. NAIL RIGHT SIDE CENTER

RENEWAL

Monument Set (Procedure and Description)

MONUMENT DETAIL

New Accessories

- 14" BURNED DEAD D. FIR S11°W 9.2 FT
3 1/2" PK NAIL RIGHT SIDE CENTER NOT
BLAZED OR SCRIBED
- 12" BURNED DEAD D. FIR N3°W 18.0 FT
3 1/2" PK NAIL RIGHT SIDE CENTER NOT
BLAZED OR SCRIBED

Sketch of Monument, Accessories, and General Area

Location & Comments

Lat 43°24'01.32"N
Long 122°48'03.93"W

FOR SKETCH SEE ATTACHED
SHEET

CORNER IS NEAR
BOTTOM OF N. Slope
600 FT ± FROM
FOREST ROAD

AREA BURNED
9-2020

Comp. Decline. 14 1/2° E

Agency DCSD
Party Chief S. F. AUSE
Note keeper
Witnesses J. LORSUNG

REGISTERED
PROFESSIONAL
LAND SURVEYOR

Ronald A. Quimby


OREGON
JULY 14, 1978
RONALD A. QUIMBY
1654

EXPIRES: 12/31/2022

CS 67/54-13

T25S, R01W, 400440

8/16/22

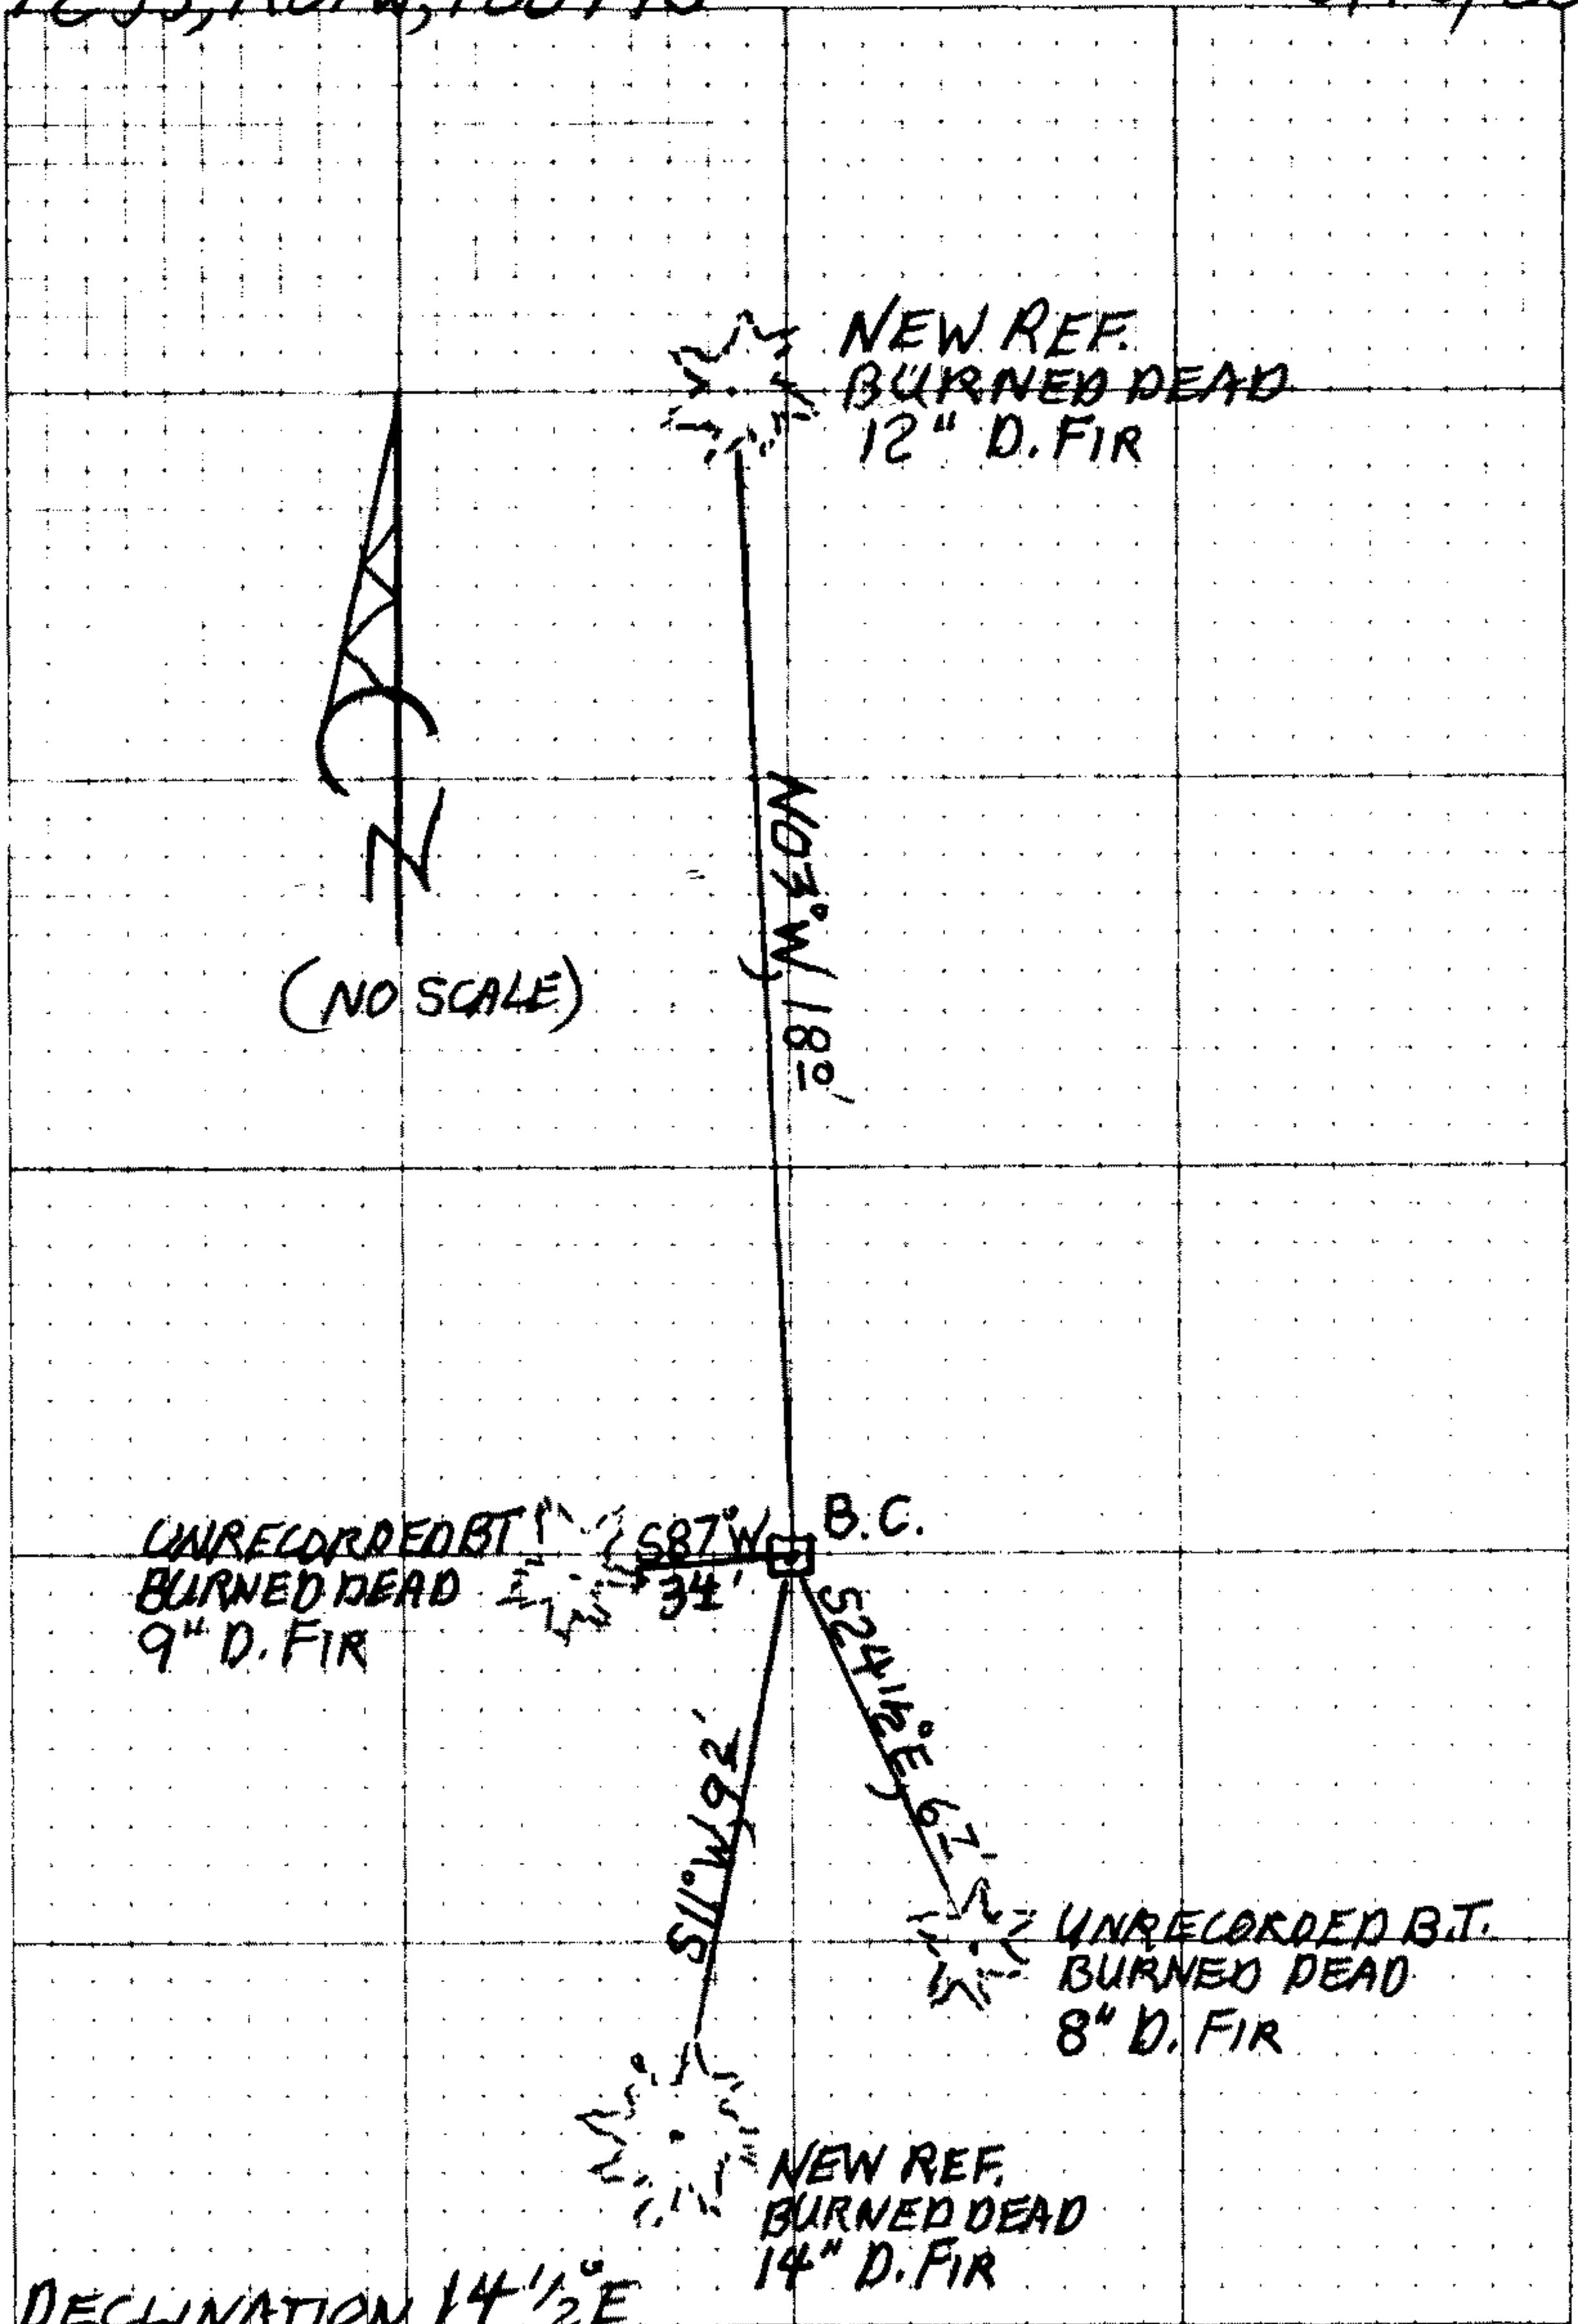

CS 67/54-13
314

GPS 8/16/22
TIME - 11:00
H.I. - 2.000M

8/16/22

TOWNSHIP 25 RANGE 01 POINT IDENTIFIER # 400440

PRIMARY CORNER DESCRIPTION 1/4 Cor Secs 15 & 16

Alias _____	Description _____
Alias _____	Description _____
Alias _____	Description _____
Alias _____	Description _____

GLO Survey by Hezekiah H. Johnson, under Contract #721, dated May 1, 1900 (DCSO records Vol. 9 Page(s) 3536)

Set a basalt stone, 14x10x8", 10" in the ground for 1/4 sec. cor., marked 1/4 on W face, from which
A hemlock, 17" dia. bears S.44°30'E. 4 lks., mkd: 1/4 S15 BT
A dogwood, 5" dia., bears N.38°W., 24 lks., mkd: 1/4 S16 BT.

V.W. Hosford - For: Evans Products Co. - April 5th thru Nov. 25, 1960 - C.S. File 51/152 & M 20-2

Found - Orig. corner stone in place.
BT for Sec. 15 is OK, now 22" dia.
BT for sec. 16 was gone.
New BT - 12" Hemlock bears S.72 1/4°W. 35.3 ft mkd: 1/4 S16 253 BT

DECLINATION 14 1/2° E

Douglas Co. Surveyors Office - Vernon "Ray" Tracy - Jack Heritage - Aug. 1966 - C.S. File 52/30-22

Found - Basalt stone at corner point 10x10x12" mkd: "X" on top.

GONE NO EVID, Orig. 17" Hemlock S.44 1/2°E., 2.6 ft. down & burned, shows scar.

GONE NO EVID, 12", now 13" hemlock now dead, S.72 1/4°W., 35.3 ft., shows scribe on unhealed blaze. 1960

Set *PROT. 10"* Brass cap at cor. mkd: County Surveyors Office 1966 T25S 1/4 S16|S15 R1W & place stone alongside.

2 1/2" BC ON 1" ID IP

GONE POS POOTHOLE BURNED TO GROUND

16" Hemlock S.46°E., 45.1 ft. mkd: 1/4 S15 CS BT.

23" D. Fir S.86 1/2°E., 24.2 ft. mkd: 1/4 S15 CS BT. *REMAINS METAL RAIN CAP*

Note - Due to logging to W of corner, there are no trees available. Corner lies on N-S cutting line.

CORNER IS NEAR BOTTOM OF NORTH SLOPE ≈ 600 FT. EAST FROM FOREST RD.

UNRECORDED BTS, FOREST SERVICE CONTRACT?

OCTOBER 2014, LS 2339 ON FND TAG

NEW REF'S

ADD 3 1/2" PK RSC TO TWO UNRECORDED BTS

UNRECORDED 8" BURNED DEAD FIR PART HEALED BLZ ILLEG SCRIBG S24 1/2° E, 67 FT

NEW 14" BURNED DEAD D. FIR NOT BLZD OR SCRIBD 3 1/2" PK RSC S11° W, 92

UNRECORDED 9" " " PART HEALED BLZ ILLEG SCRIB S87° W, 34 1

NEW 12" " " NOT BLZD OR SCRIBD 3 1/2" PK RSC N03° W, 180

CS 67/54-13 4/4