

GOVERNMENT CORNER RESTORATION FORM

FILED

TOWNSHIP 25S RANGE 1W SEC. 26

PLSS # 500240

Date: 10/18/2022 By: XC

This survey consists of:

Map: _____

DOUGLAS COUNTY OREGON

DATE 8-16-22

Narrative: _____

Corner Rpt: CS 67/54-14

Corner Designation

1/4 COR 527/526

DOUGLAS COUNTY SURVEYOR

Monument(s) Found: (Condition and Source)

2 1/2" DCSO BRASS CAP ON
1" ID IRON PIPE UP 12"

___ Condition report

___ Not Found

Renewed

___ Unrecorded

___ Surveyed In

Previous Renewals

DCSO 1966 CS 52/30-20
DCSO 1981 CS 61/29-17
BLM Resurvey 2010-2011
Vol 57 pg 22813

MONUMENT DETAIL

County Surveyors
OFFICE
T25S R1W
1/4 527/526
1966

Accessories Found

DCSO BT'S

- Burned - Dead 21" Hemlock S59°W 10.5 FT
(Rec S52°14'W 10.5) ADD 3 1/2" PK RIGHT SIDE
Center Healed Double BLAZE
- LARGE Root Hole N32°14'E 42.4 FT
- BURNED DEAD 13" Hemlock S57°14'E 60.4 FT
(Rec 61.0 FT) Fully Healed Double BLAZE
ADD 3 1/2" PK RIGHT SIDE Center
- 26" D. Fir S72°12'W 77.1 FT Fully Healed
Double BLAZE ADD 3 1/2" PK Nail RIGHT
Side Center

C.S. File 67/54-14

Monument Set (Procedure and Description)

MONUMENT DETAIL

New Accessories

BURNED DEAD 22" Double Trunk Hemlock
 S 22° E 12.0 FT 3 1/2" PK NAIL RIGHT SIDE
 Center Not Blazed or Scribed

Sketch of Monument, Accessories, and General Area

Location & Comments


LAT 43° 22' 17.37" N
 LONG 122° 46' 51.73" W

For Sketch see Attached
 Sheet

PREP BURNED
 9/2020

Comp. Decline 14 1/2° E


Agency DCSO
 Party Chief S F/ause
 Note keeper
 Witnesses J. Lot Sung

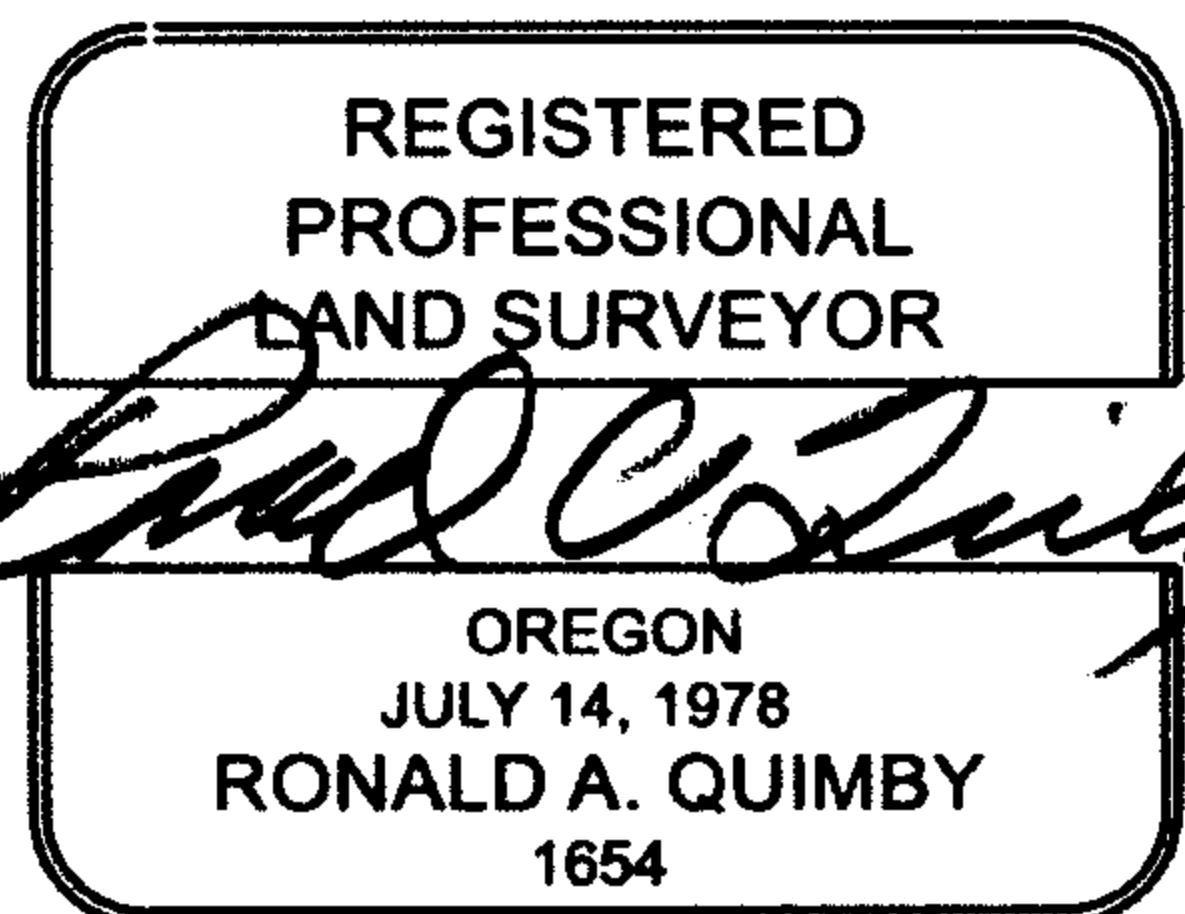

CS 67/54-14
 2/4

T25S, R01W, 500240

8/16/22

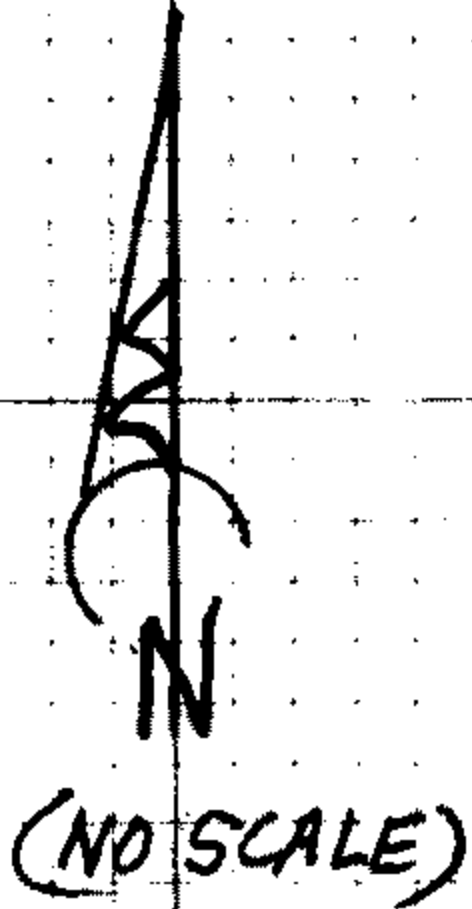

TREE OUT OF POS.

1981 DCSD BT
LARGE INDISTINCT
ROOT HOLE

1966 DCSD BT
BURNED DEAD
21" HEMLOCK
S54°W, 105'

N32°40'E, 42'

S72 1/2°W, 77'

NEW REF.
BURNED DEAD
22" DOUBLE
TRUNK HEMLOCK
S22°E, 120'

N57 3/4°E, 60 1/2'

1981 DCSD BT
LIVE 26" D. FIR

1981 DCSD BT
BURNED DEAD
13" HEMLOCK

DECLINATION 14 1/2°E

CS 67/54 14
3/4

MM GPS 8/16/22
TIME - 12:50
H.I. - 2,000M

8/16/22

TOWNSHIP 25 RANGE 01 POINT IDENTIFIER # 500240

PRIMARY CORNER DESCRIPTION 1/4 Cor. Secs. 26 & 27

Alias _____	Description _____
Alias _____	Description _____
Alias _____	Description _____
Alias _____	Description _____

BLM Dependent Resurvey by Kenneth W. Saveland, Cadastral Surveyor, under Group No. 25001006, Surveyed Aug. 2010/April 2011 - (DCSO records Vol. 57 Page(s) 22813)

The 1/4 sec. cor. of secs. 26 & 27, perpetuated by the Douglas County Surveyor's Office in 1966, subsequently perpetuated by Quibell, in 1981, monumented with an iron post, 1 1/4" dia., firmly set, projecting 10" above ground, with a brass cap (properly) mkd.

DCSO
2 1/2" BK / 1" DIP
PROT 12"

from which the remains of the original bearing trees

BURNED TO GROUND NOW INDISTINCT ROOT HOLES

A decayed hemlock stump, size indeterminate, bears N.68°E., 23.1 ft., with a hollow blaze.

A decayed fir stump, size indeterminate, bears S.35°W., 5.3 ft., with no marks visible.

and the remains of BTs mkd by the Douglas Co Surveyors Office

A decayed hemlock stump, size indeterminate, bears N.26 1/4°E., 44.5 ft., with no marks visible.

BURNED DEAD 21"

A hemlock, 17" dia., bears S.52 3/4°W, 10.6 ft., with a healed double blaze. FHDB 554°W, 10.5 FT.

ADD 3 1/2" PK TO RSC OF FND. BTs

and bearing trees mkd. by Quibell.

FALLEN OUT OF PDS

A hemlock, 13" dia., bears N.32 3/4°E., 42.4 ft., with a healed double blaze. FHDB

LRG. ROOT HOLE

BURNED DEAD

A hemlock, 13" dia., bears S.57 3/4°E., 60.4 ft., with a healed double blaze. FHDB

ALIVE 26" D. FIR

A hemlock, 25" dia., bears S.72 1/2°W, 77.1 ft., with a healed double blaze. FHDB

NEW REFS

3 1/2" PK R.S.C.

BURNED DEAD

22" HEMLOCK DOUBLE TRUNKS NOT BLZD OR SCRBD ✓ S22°E, 12° FT

DECLINATION 14 1/2° E

CS 67/54-14

4/4