

GOVERNMENT CORNER RESTORATION FORM

FILED

TOWNSHIP 255 RANGE 1W SEC. 36 PLSS # 640100

Date: 10/18/2022 By: JC  
This survey consists of:

DOUGLAS COUNTY OREGON

DATE 8-17-22

Map: \_\_\_\_\_

Narrative: \_\_\_\_\_  
Corner Rpt: CS 67/54-15

DOUGLAS COUNTY  
SURVEYOR

Corner Designation

South 1/4 S 36 only

Monument(s) Found: (Condition and Source)

2 1/2" BRASS CAP ON 1"  
IRON Pipe proj 14"

\_\_\_ Condition report

\_\_\_ Not Found

Renewed

\_\_\_ Unrecorded

\_\_\_ Surveyed In

Previous Renewals

GLD Resurvey 1921 Vol 22 pg 9238

DCSO 1962 CS 52/30-11

DCSO 1966 CS 52/30-28-A

RANSOM 2010 CS 65/72-13

MONUMENT DETAIL

Accessories Found

- Mostly burnt out 3 FT TALL Fir Stump N 85° W  
104.9 FT
- Mostly burnt away 4" x 8' Fir N 15° 30' W 30.0 FT  
Blaze Gone
- Burnt-Dead 17" D. Fir S 71° E 48.0 FT  
(Rec 48.5 FT) Fully Healed Double BLAZE  
ADD 3 1/2" PK nail RIGHT side Center

C.S. File 67/54-15

RENEWAL

Monument Set (Procedure and Description)

MONUMENT DETAIL

New Accessories

- Burnt-dead 16" D. Fir N11°E 19.0 FT 3 1/2" P.K  
RIGHT SIDE Center Not Blazed or Scribed
- Burnt-dead 14" D. Fir N46 1/2° E 26.7 FT 3 1/2"  
PK RIGHT SIDE Center Not Blazed or Scribed
- 5/8" x 30" I. Rod with DCSO yellow Plastic  
CAP S43°W 21.6 FT up 8"
- 5/8" x 30" I. Rod with DCSO yellow Plastic  
CAP N53 1/4° W 20.6 FT up 8"

Sketch of Monument, Accessories, and General Area


Location & Comments

LAT ~~43° 04' 13.16" N~~ 43° 21' 00.54" N  
 LONG ~~122° 15' 44.81" W~~ 122° 45' 03.65" W

CORNER FALL JUST  
 SOUTH OF PUT  
 ROAD BEARS E-W  
 Area Burnt  
 9-2020

For sketch see attached  
 Sheet

Comp. Decline. 14 1/2° E  
 Agency DCSO  
 Party Chief S. Fause  
 Note keeper  
 Witnesses J. LORSUNG

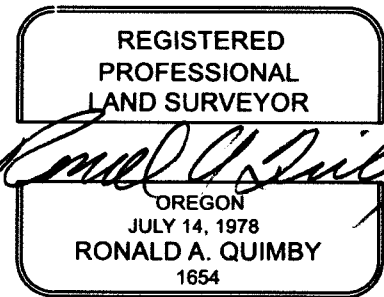


EXPIRES: 12/31/2022

CS 67/54-15  
 2/5

T25S, R01W, 640100

8/17/22

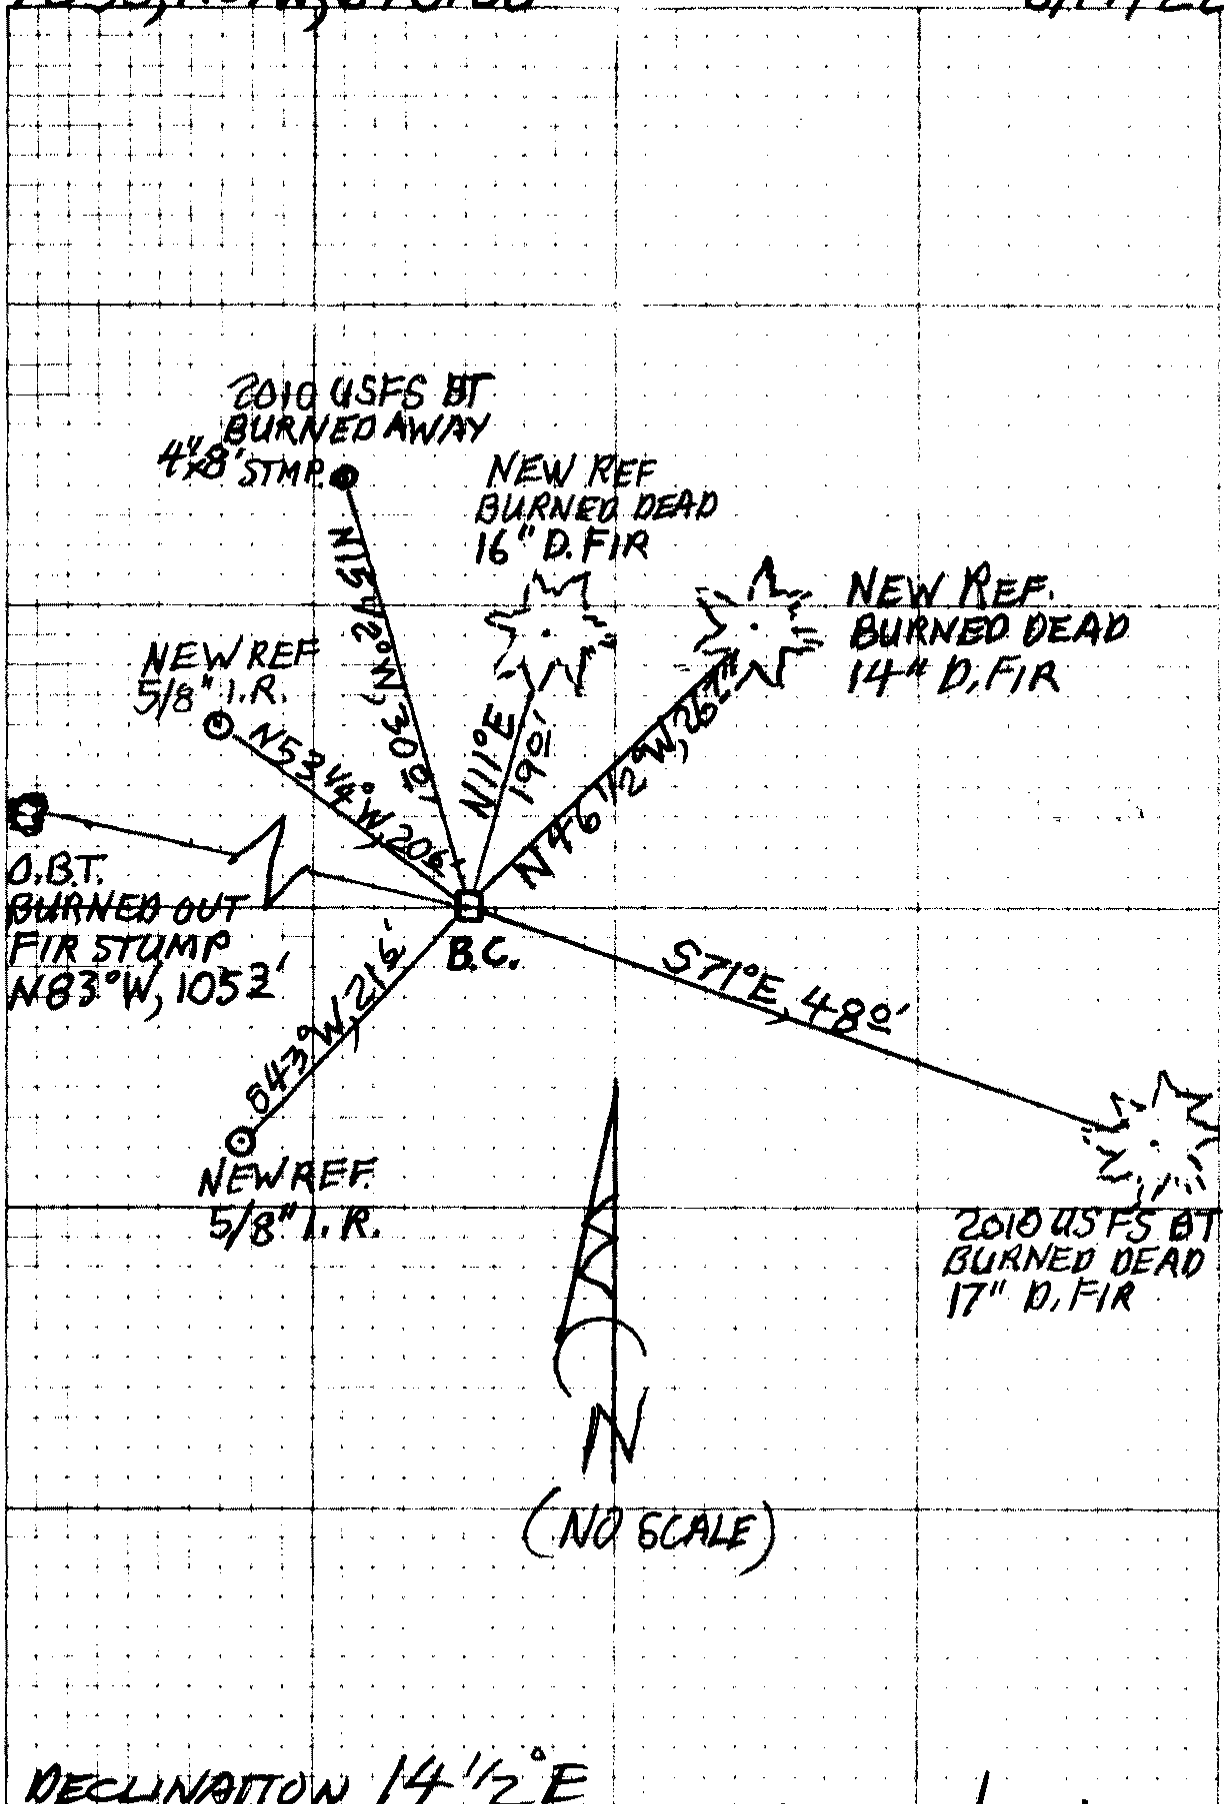

CS 67/54-5  
3/5

TOWNSHIP 25 RANGE 01 POINT IDENTIFIER # 640100

8/17/22

PRIMARY CORNER DESCRIPTION So. 1/4 Cor. for Sec. 36 only

Alias _____	Description _____
Alias _____	Description _____
Alias _____	Description _____
Alias _____	Description _____

GLO survey by Hezekiah H. Johnson, Deputy Surveyor, under Contract #721, dated May 1, 1900 - (DCSO rec Vol. 8 Pg) 3500)

-----

Set a Fir post 3 ft. long, 3" sq., 24" in the ground for 1/4 sec. cor. marked 1/4 S36 on N. and S1 on S. faces, from which

A Fir 14" dia., bears S.86°E., 162 lks. mkd. 1/4 S1 BT.

A Fir 10" dia., bears N.87°W., 195 lks. mkd. 1/4 S36 BT.

GLO resurvey by Otto L. Draper, U.S. Transitman - Under instructions dated March 12, 1921 - (DCSO rec Vol 22 Pg 9238)

-----

Intersect the 1/4 sec. cor. established for secs. 1 and 36 which is a squared Fir stake, 3x3x18 ins. above ground, badly decayed, no marks legible.

This cor. will hereafter refer to sec. 36 only, destroy scribe marks on old SW BT. In place of old cor. stake:

Set an iron post 3 ft. long, 1" dia., 27" in the ground for the 1/4 sec. cor. of sec. 36 only, with brass cap mkd.

1/4 S 36  
1928

from which

A Fir snag, 14" dia., bears N.86°E., 158 lks. (not S.86°E., 162 lks.) mkd. 1/4 S36 BT (not 1/4 S1 BT) old BT).

A Fir 30" dia., bears S.87°W., 159 lks. (not N.87°W., 195 lks.) mkd. 1/4 S1 BT (not 1/4 S36 BT) old bearing tree.

A Fir 18" dia., bears N.26°E., 52 lks. mkd. 1/4 S36 BT.

A Fir 10" dia., bears N.63°W., 81 lks. mkd. 1/4 S36 BT.

Milo E. Godfrey, Deputy - Vernon Tracy - Mike Stone - Aug. 1962 - C.S. File 52/30-11

-----

Found - Brass cap set by GLO in 1928 at cor.

18" Fir N.26°E., 34.3 ft. good scar.

10" Fir N.63°W., 53.5 ft. good scar.

30" Fir N.82°W., (Not S.87°W.) 104.9 ft. - previously cut open & scribing visible.

14" Fir snag, N.86°E., 104.3 ft. old axe mks visible

Fd. ok by V. R. Tracy, 10/1966 C.S. File 52/30-28A

RENEW 8/17/22

John Ransom, USFS - Jonathan Drew - 10/2010 - C.S. File 65/72-13

-----

Found <sup>2 1/2"</sup> Standard GLO 3" Brass Cap on 1" Iron Pipe projecting <sup>14"</sup> 11" above ground. Cap marked: "1/4 S36 1928"

30" Fir Snag N.82°W., 104.9 ft 6' tall snag tag reads N.83°W. 105.3 ft

GONE - 10" Fir Stump N.63°W., 53.5 ft., healed face.

GONE - 18" Fir Stump N.26°E., 34.3 ft., healed face. cont.

MOSTLY BURNED OUT STUMP 3 FT TALL

MM GPS 8/17/22  
TIME - 8:45  
H.I. - 2.000M

CS 67/54-15  
415

1  
OVER →

TOWNSHIP 25 RANGE 01 POINT IDENTIFIER # 640100

PRIMARY CORNER DESCRIPTION So. 1/4 Cor. for Sec. 36 only

Alias _____	Description _____
Alias _____	Description _____
Alias _____	Description _____
Alias _____	Description _____

New - Painted 6" Band around BTs and face scars, attached new nails to signs. Cleared Brush around corner. marked new trees:

*MOSTLY BURNED AWAY 4" X 8"*

8" Fir BRS N.15°30'W., 30.0 ft scribed "1/4 S36" "BT" on double blaze *BLZ GONE*

*NO EVID.* 8" Fir BRS N.54°30'E., 27.2 ft scribed "1/4 S36" "BT" on double blaze

*BURNED DEAD* 16" D. Fir BRS S.71°E., 48.5 ft scribed "X" "BT" on double blaze *FHDB*

Note - Corner falls just south of recently rebuilt PVT road bears E-W, take Scardman Creek Road to 018 spur brs East, follow east bound road to where fence on south side begins, just West of where fence starts is more open timber and posted line visible from road, corner falls in this open timber no more than 100 ft from road.

REMARKS-  
Line Maintined .5 mile East  
Line Maintined .5 mile West  
New BTs measured with staff compass (15°45' DEC) and tape.  
New BTs include 3/4" brass washer nailed to face between B & T on lower blaze.

PLANE COORDINATE POSITION DATA

State	OR	Zone	UTM-10M
North			4799704
East			520181
Estab. By			GCDB

NEW REFS

*BURNED DEAD* 16" D. FIR NOT BLZD OR SCRIBD 3 1/2" PK RSC N11°E, 19 2

" " 14 " " " N46 1/2°E, 26 2

5/8" I.R / DCSO YELLOW PLSTC CAP PROT 8" S43°W, 21 6

" " " " N53 1/4°W, 20 6

DECLINATION 14 1/2°E

CS 67/54-15  
5/5