

GOVERNMENT CORNER RESTORATION FORM

FILED

TOWNSHIP 26 S RANGE 1 W SEC. 18 PLSS # 100 440

Date: 10/18/2022 By: X  
This survey consists of:

DOUGLAS COUNTY OREGON

DATE 9-7-22

Map: \_\_\_\_\_

Narrative: \_\_\_\_\_

Corner Rpt: CS 67/54-17

Corner Designation

W 1/4 COR 5 18 only

DOUGLAS COUNTY  
SURVEYOR

Monument(s) Found: (Condition and Source)

3" BRASS CAP ON 2" I.D  
Iron pipe Down - 1"

\_\_\_ Condition report

\_\_\_ Not Found

Renewed

\_\_\_ Unrecorded

\_\_\_ Surveyed In

Previous Renewals

GLD Survey 1913 1/6/10 pg 4263  
GARRETT 1972 M 47-7  
DCSO 1992 CS 64/23-21  
STANDLY ODOT 2007 ST HWY  
138-011C

MONUMENT DETAIL

T 26 S R 1 W  
1/4 | 5 18  
1972  
RPLS 544

Accessories Found

BURNED 23" FIR SNAG N 32° E 58.4 FT  
Fully Healed Double BLAZE  
SAWN BURNED 26" X 1' D. FIR STUMP S 21 1/2° E  
59.7 (Rec 60.2) B&D TO 3 1/2" PK NAIL TOP  
Center  
UNRECORDED BT  
BURNED DEAD 7" CEDAR HIGH-LOW X BT  
BLAZE N 55° E 24.1 FT

C.S. File 67/54-17

Monument Set (Procedure and Description)

MONUMENT DETAIL

Blank lines for monument set procedure and description.

New Accessories

43" X 3 FT TALL SAWN BURNED D FIR STUMP N 27 1/2° W 33.6 FT 3 1/2" MAG NAIL TOP CENTER

Sketch of Monument, Accessories, and General Area

Location & Comments

MON ON LARGE FLAT Bench 10 FT North of & GRAVEL driveway Running E-W LAT 43°18'23.96"N LONG 122°52'23.63"W See attached sheet for sketch

AREA BURNED 9-2020 Comp. Decline 14 1/2° E Agency DCSO Party Chief S. F. AUSE Note keeper Witnesses J. LORSUNG

REGISTERED PROFESSIONAL LAND SURVEYOR

Ronald A. Quimby

OREGON JULY 14, 1978 RONALD A. QUIMBY 1654

EXPIRES: 12/31/2022

T265, R01W, 100440

9/7/22

1972  
GARRET B.T.  
23" CEDAR SNAG

NEW REF  
43" x 3' FIR  
STUMP


N 27 1/2° W, 53 1/2'

N 32° E, 58 1/2'

UNRECORDED BLM BT  
DEAD BURNED  
7" CEDAR

N 55° E, 24 1/2'

B.C.

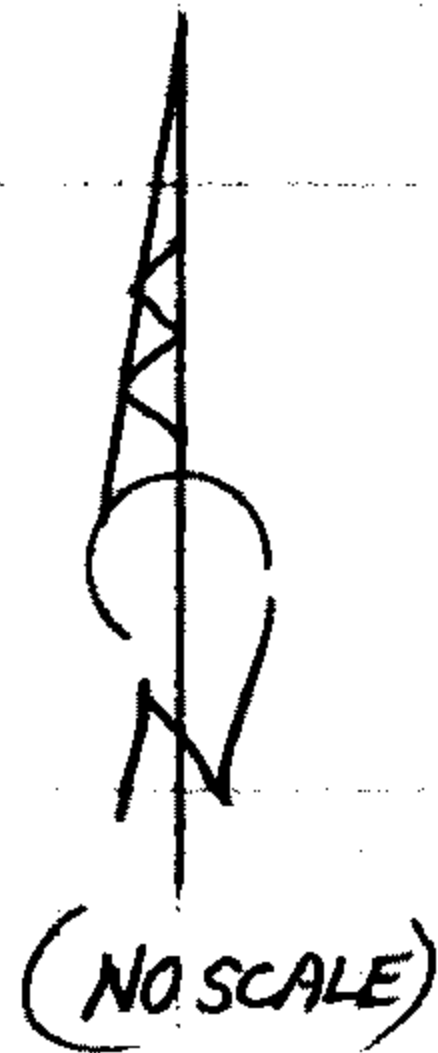

S 21 1/2° E, 59 1/2'

GRAVEL DRIVE

1972  
GARRET B.T.  
26" x 1' FIR STUMP

DECLINATION 14 1/2° E

CS 67/54-17

3/4

MM GPS 8/24/22  
TIME - 11:10  
H.I. - 2,000M

RENEWED 9/7/22

TOWNSHIP 26 RANGE 01 POINT IDENTIFIER # 100440

PRIMARY CORNER DESCRIPTION W. 1/4 Cor. for Sec. 18 only

Alias _____	Description _____
Alias _____	Description _____
Alias _____	Description _____
Alias _____	Description _____

GLO survey by Fred Mensch, Deputy Surveyor, under Contract #797, dated April 19, 1910 - (DCSO records Vol. 10 Page(s) 4163)

At point midway on W. bdy. of sec. 18 (4.73 chs. S.0°47'W. of the 1/4 sec. cor. on E. bdy. sec. 13, T26S R2W) I establish 1/4 sec. cor. on W. bdy. of sec. 18, as follows:  
Set a basalt stone 15x10x8 ins., 10" in the ground for 1/4 sec. cor. on W. bdy. of sec. 18, marked 1/4 on E. face, from which  
A Fir 30" dia., bears N.37°E., 31 lks. dist. mkd. 1/4 S18 BT  
A Cedar 10" dia., bears S.57°E., 52 lks. dist. mkd. 1/4 S18 BT.

Fd. and tied corner in GLO survey by C.M. Collier, Deputy Surveyor, under Instructions dated May/Sept. 1913 - (DCSO records Vol. 10 Page(s) 4263)

Don E. Garrett - For: United States of America - Oct. 1972 M 47-7

3 INCH BC/2" I.D. I.P. 1" BELOW GRND. ✓

Set brass cap marked "T26S R1W 1/4 S18 1972 RPLS 544.", from which

Fir bears N.32°E., 58.4 ft. scribed 1/4 S18 BT. FHDB

Fir bears S.21 1/2°E., 60.2 ft. scribed 1/4 S18 BT. ~~NO EVIDENCE~~

BURNED SNAG 23" ✓  
SAWN BURNED-~~✓~~ ✓  
D. FIR STUMP 26" x 1 FT TALL ✓ 59? BED TO 3 1/2" MAG NAIL TOP CNTR.

Fd. OK, Feb. 4, 1992 by DCSO - C.S. File 64/23-21

James M. Stanley, ODOT - Sept/Nov. 2007 - St. Hwy 138-011C

Fd. 3" brass disk stamped "RPLS 544 T26S R2W R1W 1/4 S18 1972" (10-16-07)

N. 606721.699  
E. 4290330.605

UNRECORDED BLM BT

BURNED DEAD 7" CEDAR HIGH-LOW "X" "BT" BLZ. N55°E, 24 1/2 FT.

NEW REF

43" x 3 FT TALL SAWN, BURNED D. FIR STUMP 3 1/2" MAG NAIL IN TOP CENTER BEARS N27 1/2° W, 33 1/2 FT. CS 67/54-17  
4/4

MON. ON VERY LARGE FLAT BENCH LAND, 10 FT NORTH FROM E OF GRAVEL DRIVEWAY RUNNING M/L EAST-WEST

S 02° 21' 15" W, 272.91 FROM EQ 13 43.30665 43° 18' 23.9" 122.87322 122° 52' 23.6"