

GOVERNMENT CORNER RESTORATION FORM

FILED

TOWNSHIP 26S RANGE 2W SEC. 6 PLSS # 100600

Date: 10/18/2022 By: X

This survey consists of:

DOUGLAS COUNTY OREGON

DATE 9-16-22

Map: _____

Narrative: _____

Corner Rpt: CS 67/54-18

Corner Designation

T 26-2 S. 6 & 7

T 26-3 S 1 & 12

DOUGLAS COUNTY SURVEYOR

Monument(s) Found: (Condition and Source)

Condition report

Not Found

Renewed

Unrecorded

Surveyed In

3/4" BLM BRASS CAP ON
2 1/2" I. Pipe up 8" - 2" I. Pipe
ON WNW Edge of BRASS CAP up 36"

Previous Renewals

GLO Resurvey 1879 Vol 10 pg 4381

GLO Resurvey 1913 Vol 10 pg 4253

BLM Resurvey 1959 Vol 30 pg 12724

BLM Resurvey 1962-1963 Vol 32 pg 13372

DCSO 1978 CS 59/44-14

Weyco 1969 CS 53/114-3

DCSO 2007 CS 67/24-46

MONUMENT DETAIL

T 26 S

R 3 W | R 2 W

S 1 | S 6

S 12 | S 7

1959

Accessories Found

DCSO 1978 BT'S

• Burnt - Dead 28" Cedar N 83° E 20.0 FT Burnt
Out Face

• A 3" x 3' above Ground in 20' x 20' boulder
S 86° W (Rec S 88 1/2° W) 32.0 FT

• 8" x 7' Sawed Chinquapin Stump N 53° W (Rec
N 50° W) 71.5 FT Healed double BLAZE

C.S. File 67/54-18

1/4

Monument Set (Procedure and Description)

MONUMENT DETAIL

New Accessories

- 5/8" x 30" I. Rod with DCSD yellow Plastic Cap SSW 63.4 FT in fill slope of Road Shoulder Projecting 3"

Sketch of Monument, Accessories, and General Area

Location & Comments

OCRS State PLANE Coordinates
 Cottage Grove - Canyonville
 Zone
 N 180887.011
 E 255081.218
 For sketch see Attached
 Sheet

CORNER IS 30' ± OF
 ROAD
 AREA Burnt
 9-2020
 Comp. Decline. 14 1/2° E
 Agency DCSD
 Party Chief S. Flause
 Note keeper
 Witnesses J. Loring

REGISTERED
 PROFESSIONAL
 LAND SURVEYOR

Ronald A. Quimby

OREGON
 JULY 14, 1978
 RONALD A. QUIMBY
 1654

EXPIRES: 12/31/2022

CS 67/54-18
2/4

T265, R02W, 100600

9/16/22

1978
DC50 BT
8" x 7' CHINA STUMP

N 53° W, 718'

20' x 20'
BOULDER

1978
DC50 REF.
"X" IN ROCK


N 83° E
20'

1978
DC50 BT
28" BURNED
DEAD CEDAR

S 05° W, 634'

GRAVEL RD.

NEW REF.
5/8" I.R./PLSTC. CAP

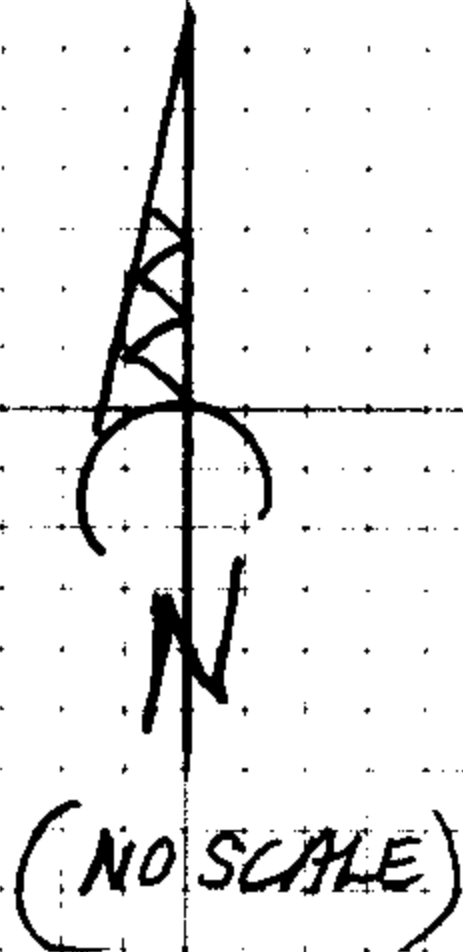

DECLINATION 14 1/2° E

TOWNSHIP 26 RANGE 02 POINT IDENTIFIED #

PRIMARY CORNER DESCRIPTION Sec Cor 6 & 7: 1 & 2

Alias	Description
Alias	Description
Alias	Description
Alias	Description

2" x 4 FT I.P. ON WNW EDGE OF B.C. PROT. 30
THIS IS 1969 WEYERHAUSER MON.

Doug. County Surveyors Office - R.B. Kimberlin
S.J. Flause - Jan. 10, 1978 - C.S. File 59/46

Found - 1959 Cadastral brass on a 2 1/2" I.P. base on ground properly marked.

GONE NO EVID - 15" now 36" Cedar stump is pushed over. Position bears approx. S. 60° W. 29.0 ft. with visible blaze. (OBT)

GONE NO EVID. - Remains of a Fir stump bears N. 46° E. 58.1 ft. 12" now 13" Cedar snag bears S. 73° E., 27.0 ft. with scribing "T26S R2W S7 BT" in single blaze (1959 resurvey)

GONE NOW IN RD - 50" Fir stump with a Weyerhaeuser tag and bears S. 60° W., 35.0 ft.

NO EVID, GONE - 28" Fir stump with a Weyerhaeuser tag and blaze bears N. 59° W., 47.4 ft.

BURNED DEAD New BTs - 13" Cedar with "MR" carved in West face bears N. 83° E., 20.0 ft. double blazed and scribed "T26S R2W S6 CS BT" BURNED OUT FACE

GONE UNDER FIRE DEBRIS - 10" D. Fir bears S. 20 1/2° E., 124.1 ft. double blazed & scribed "T26S R2W S7 CS BT".

3" "X" chiseled 3 ft. above ground in a 20 ft. x 20 ft. boulder bears S. 88 1/2° W., 32.0 ft. 586° W

8" x 7 FT SAWN STAMP 6" Chinquapin bears N. 50° W., 71.8 ft. double blazed and scribed "T26S R3W S1 CS BT". FHDP

Corner is 30 ft. north of road. N 53° W

DECLINATION 14 1/2° E

See C.S. File 53/114-3 for Weyerhaeuser 1969 corner report. Added two new references, described in above DCSO corner visit.

Douglas Co. Surveyors Office - Stephen J. Flause - John Pike - 11/8/2007 - C.S. File 67/24-46

Fd. Ok, as per 1978 renewal.

NEW REF.

5/8" x 30" IR / YELLOW PLST. PROT 3" IN S 05° W, 63 1/4
DCSO CAN FILL SLOPE SHOULDER

ORCS. COCKRUS COFFAGE GRV, CAMDENVILLE

N = 180887.011 FT. E = 255081.218

CS 67/54-18
4/4