

GOVERNMENT CORNER RESTORATION FORM

FILED

TOWNSHIP 255 RANGE 2W SEC. 16

PLSS # 340400 Date: 10/19/2022 By: X  
This survey consists of:

DOUGLAS COUNTY OREGON

DATE 9-27-22

Map: \_\_\_\_\_  
Narrative: \_\_\_\_\_  
Corner Rpt: CS 67/54-2

DOUGLAS COUNTY  
SURVEYOR

Corner Designation

1/4 COR S16  
S 21

Monument(s) Found: (Condition and Source)

2 1/2" DCSD BRASS CAP ON  
1 1/2" I. PIPE UP 8"

\_\_\_ Condition report  
\_\_\_ Not Found  
 Renewed  
\_\_\_ Unrecorded  
\_\_\_ Surveyed In

Previous Renewals

DCSD 1948 CS 39/149 m 12-34  
DCSD 1960 CS 49/102  
BLM Resurvey 1962 Vol 32 pg 13233  
DCSD 1995 CS 64/63-4  
BLM Resurvey 2001-2002  
Vol 54 pg 20934-5

MONUMENT DETAIL

County Surveyors  
T255  
1/4 S16 | S  
R2W | 21  
OFFIC BLM  
1962

Accessories Found

BT By Irving 1948  
Burnt-Dead 34" Cedar S35 1/4°W 223.7 Rec  
Healed BLAZE  
BT by Byron  
38" Cedar N56°E 64.3 FT (Rec N58°E 65.3 FT)  
Healed BLAZE ADD 3 1/2" MAG NAIL RIGHT  
Side Center  
Burnt- Sawd 19" x 1 1/2' Fir Stump N29°E 29.0 FT  
(Rec N30°E 28.8 FT) 3 1/2" MAG NAIL Top Center  
BLAZE IN Stump  
13" x 7 1/2' Fir Stump S41°W 27.1 FT (Rec S42°W  
27.0 FT) Add 3 1/2" MAG NAIL Top Center  
BLAZE IN Stump  
Alum. Angle Iron Post 1 Foot E & W

C.S. File 67/54-21

Monument Set (Procedure and Description)

MONUMENT DETAIL

Blank lines for Monument Set (Procedure and Description)

New Accessories

Blank lines for New Accessories

Sketch of Monument, Accessories, and General Area

Location & Comments


LAT 43°23'18.09"N  
LONG 122°56'37.26"W

CORNER IS 50'+  
EAST OF PAVED  
ROCK CR ROAD

AREA BURNED  
9-2020

Comp. Decline. 14 1/2° E

Agency DCSD  
Party Chief S. F. HAUSE  
Note keeper  
Witnesses J. LORSUNG

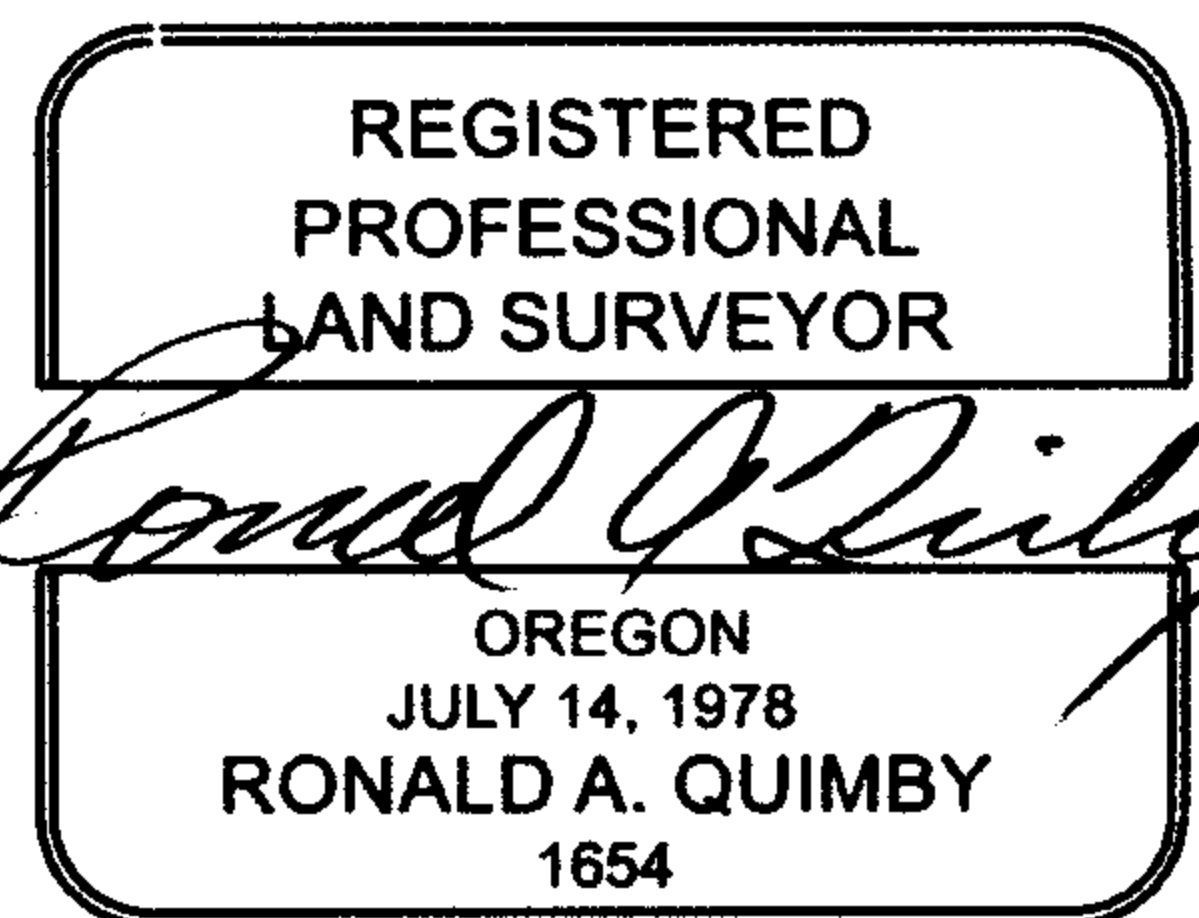

CS 67/54-21  
2/3

9/27/22

TOWNSHIP 25 RANGE 02 POINT IDENTIFIER # 340400

PRIMARY CORNER DESCRIPTION 1/4 Cor. Secs. 16 & 21

Alias _____	Description _____
Alias _____	Description _____
Alias _____	Description _____
Alias _____	Description _____

24" now 33" dia Cedar, with a unhealed blaze no scribing visible. We double blaze and rescribed "1/4 S21 CS BT", bears S.34 1/2°W., 223.5'.

22" now 35" dia R.Cedar, with a fully healed double blaze, bears N.57°E., 64.1'.

New - 10" dia D.Fir, double blazed & scribed "1/4 S21 CS BT" bears S.41°W., 26.8'.

15" dia D.Fir, double blazed & scribed "1/4 S16 CS BT" Bears N.29°E., 28.6'.

BLM resurvey by A. Bert Skeesick, Cadastral Surveyor under Group #1979, surveyed May 2001/June 2002- (DCSO rec. Vol. 54 Page(s) 20934-5)

The 1/4 sec. cor. of secs. 16 & 21, monumented with an iron post, 1 1/2" dia., firmly set, projecting 6" above ground, in a collar of stone, with brass cap mkd.

COUNTY T 25 S

1/4 S 16 R 2 W

SURVEYORS S 21

2' 2" B.C  
PROT 8"

BLM OFFICE 1962

From which a BT mkd. by Irving, in 1948, reported by Brooks

- A cedar, 34" dia bears S 35 1/4° W. 223.7 ft with healed blaze

and BT mkd. by Byron, in 1960, reported by Brooks

A cedar, 38" dia. bears N 58° E. 65.3 ft. with healed blaze

and bearing trees mkd. by Smith & Flauser, in 1995

- A fir, 17" dia., bears N 30° E., 28.8 ft with healed blaze

A fir, 11" dia., bears S 42° W., 27.0 ft. with healed blaze

BURNED DEAD  
DID NOT CHECK  
DISTANCE NOT  
PRACTICAL

BURNED SAWN  
19" X 1 1/2" STUMP

BURNED SAWN  
13" X 7 1/2" STUMP

N 56° E 64 3'

N 29° E 29 0'

41° 27 1'

ADD 3 1/2" MAG  
NAIL RSC  
ADD 3 1/2" MAG  
TOP  
BLZ. IN TREE

ALUMINUM LATH (ANGLE IRON) EAST AND WEST 1 FOOT  
MONUMENT IN OLD CRK FLOOD PLANE 280 SOUTH OF CRK  
AND 2 50' EAST OF PAVEN ROCK CRK. RD

CS 67/54-21