

GOVERNMENT CORNER RESTORATION FORM

FILED

TOWNSHIP 255 RANGE 2W SEC. 15 PLSS # 440400

Date: 10/18/2022 By: XC  
This survey consists of:

DOUGLAS COUNTY OREGON

DATE 10/5/22

Map: \_\_\_\_\_

Narrative: \_\_\_\_\_

Corner Rpt: CS 67/54-22

Corner Designation

1/4 COR S15 S22

DOUGLAS COUNTY SURVEYOR

Monument(s) Found: (Condition and Source)

\_\_\_ Condition report

3 1/4" BRASS CAP ON 2 1/2" O.D. I. PIPE 4" x 8"  
ORIG STONE ALONG SIDE. 1 1/2"

\_\_\_ Not Found

Renewed

I. PIPE ON E. EDGE UP 20"

\_\_\_ Unrecorded

Previous Renewals ROUGH MOUND OF STONE

\_\_\_ Surveyed In

Hosford 1957 CS 42/308

BLM Resurvey 1962 Vol 32 pg 13227

MONUMENT DETAIL

DCSD 1996 CS 65/9-19

BLM Resurvey 2001-2002

Vol 54 pg 20926-7

1/4 S15 S22

T256 R2W

1962

Accessories Found

DCSD BT

Rotted & Burnt 14" x 1 1/2 FT FIRE STUMP

S24 1/2° E 11.6 FT (REC S21 3/4° E)

Burnt-dead 16" CEDAR N 40 3/4° W 7.7 FT

ADD 3 1/2" MAG NAIL RIGHT SIDE CENTER

ALUM POST NNE 1 FT.

C.S. File 67/54-22

New Accessories

8" MAG Spike in Root of 14" x 1 1/2' FT Burnt  
AND Rotted Fir Stump S 28 1/2° E 11.7 FT

1996 S.E. BT

5/8" x 30" I. Rod with DCSD yellow Plastic  
Cap S 24° 14' W 94.0 FT up 15" in westerly  
Road Shoulder

5/8" x 30" Iron Rod with DCSD yellow plastic  
Cap S 76 1/2° W 75.5 FT in westerly Road  
Shoulder up 6"

Sketch of Monument, Accessories, and General Area

Location & Comments

CORNER IS APPROX 35 FT  
HIGHER AND 55' EAST  
OF Q OF GRAVEL ROAD

LAT 43° 23' 17.29" N  
LONG 122° 55' 25.49" W

AREA Burnt  
9/2020

Comp. Decline. 14 1/2" E

Agency DCSD


Party Chief S. Fause

Note keeper

Witnesses J. Lorusong

CS 67/54-22  
214

REGISTERED  
PROFESSIONAL  
LAND SURVEYOR

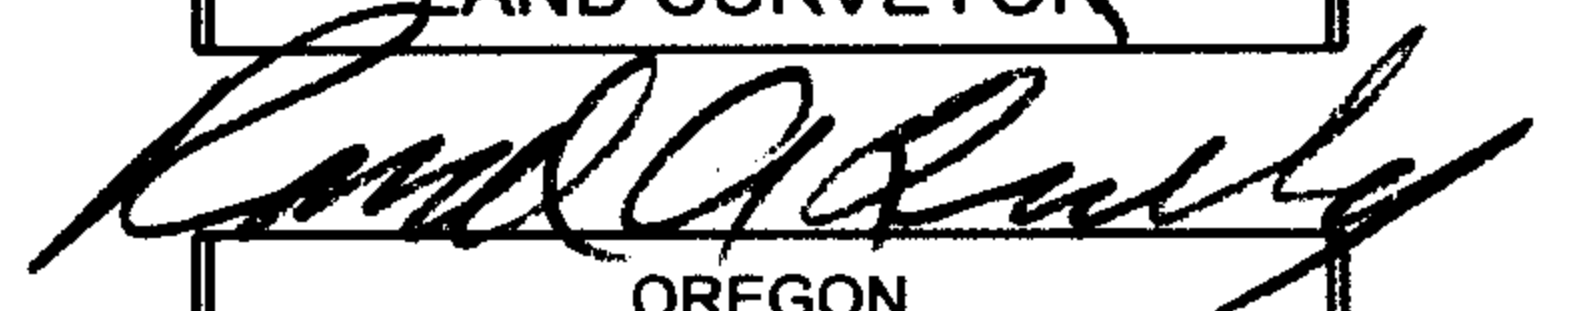

OREGON  
JULY 14, 1978  
RONALD A. QUIMBY  
1654

EXPIRES: 12/31/2022

10/5/22

TOWNSHIP 25 RANGE 02 POINT IDENTIFIER # 440400

PRIMARY CORNER DESCRIPTION 1/4 Cor. Secs 15 & 22

Alias _____	Description _____
Alias _____	Description _____
Alias _____	Description _____
Alias _____	Description _____

Douglas Co. Surveyors Office - Randall Smith, Stephen Flause;  
Sept. 26, 1996 - C.S. File 65/9-19

-----

Found - 3 1/4" dia. brass cap on a 2 1/2" O.D. iron pipe, protrudes 3" above ground. (1962 BLM)  
 1 1/2" I.D. iron pipe, protrudes 13" above ground, along NE'y edge of BC/IP  
 A broken stone that measures 24" x 10" x 6". No marks found. Stone is along north edge of BC/IP. (orig. cor. stone)  
 30" now 29" dia. 15 ft. high Hemlock snag with scribing visible on an unhealed blaze "1/4 S22 53 BT", bears S.54 1/2°W., 21.8 ft. (agrees with rec.)  
 12" now 23" dia. 3 ft. high Hemlock stump, scribing fd "1/4 S1" and a healed blaze, bears N.39°W., 5.3 ft. (agrees with rec.)  
 8" now 10" dia. 25 ft. high Cedar snag with a rotted blaze, no scribing visible, bears S.15°E., 21.1 ft. (agrees with rec.) O.B.T.

New - 7" dia. Cedar, double blazed and scribed "1/4 S15 CS BT" bears N.42°W., 7.0 ft.  
 12" dia. D.Fir, double blazed and scribed "1/4 S22 CS BT" bears S.26 1/2°E., 11.6 ft.  
 5" dia. D.Fir, double blazed and scribed "1/4 S15 CS BT" bears S.38°W., 22.5 ft.

DECLINATION 14 1/2°E

BLM resurvey by A. Bert Skeesick, Cadastral Surveyor under Group #1979, surveyed May 2001/June 2002- (DCSO rec. Vol. 54 Page(s) 20926-7)

3 1/4" BC MARK AS DESCRBD 1962 PROT 8" ROUGH STONE MOUND AROUND BASE

The 1/4 sec. cor. of secs. 15 & 22, monumented with an iron post, 2 1/2" dia., firmly set, projecting 4" above ground, with orig. stone lying alongside, and an iron pipe 1 1/2" dia., driven alongside, with brass cap (properly) mkd.

from which the remains of the original bearing trees  
 —A cedar snag, 10" dia., bears S.12°E., 21.1 ft., with no marks visible on decayed blaze. (Record, S.15°E.)

—A decayed hemlock stump, 26" dia., bears N.36°W., 4.6 ft., with illegible scribe fragments lying alongside. (Record, N.39°W.)

and remains of BT mkd by Hosford, in 1957, reported by Brooks  
 A decayed hemlock snag, 29" dia., bears S.56°W., 21.8 ft., with fragmentary scribe marks visible on open blaze and large X hacked into the bark on the side away from the corner. (Record, S.54 1/2°W.)

and bearing trees mkd. by Smith & Flause, in 1996  
 A fir, 13" dia., bears S.21 3/4°E., 11.6 ft., with healed double blaze.

SE + 1/2°E continued next page

PIPE ON EAST EDGE, PROT. 20"

NO EVID.

NO EVID.

BURNED AWAY NOT USABLE

NEW ROTTED AND BURNED 14" X 1 1/2 FT FIR STUMP

OVER ->

CS 67/54-22

3/4

TOWNSHIP 25 RANGE 02 POINT IDENTIFIER # 440400

PRIMARY CORNER DESCRIPTION 1/4 Cor. Secs. 15 & 22

Alias _____	Description _____
Alias _____	Description _____
Alias _____	Description _____
Alias _____	Description _____

**NO EVID.** — A fir, 6" dia., bears S.37°W., 22.9 ft., with fragmentary scribe marks visible on partially healed double blaze.  
**BURNED DEAD 16"** cedar, 10" dia., bears N.40<sup>3</sup>/<sub>4</sub>°W. ✓ 7.7 ✓ ft., with fragmentary scribe marks visible on partially healed double blaze. **ADD 3 1/2" MAG NAIL RSC**

**NEW REFS.**

**8" SPIKENAIL IN ROOTS OF 14" X 1 1/2 FT. ROTTED & BURNED FIR STUMP (1996 NEW SE BT) SPIKE BEARS S 28 1/2° E, 117 FT.**

**5/8" x 30" IR / YELLOW PESTIC. CAP PROT 15" IN W ST LY RD. SHLD S 24 3/4° W, 940 FT.**  
 " " PROT 6" IN " S 76 1/2° W, 755 FT.

**FOUND AN ALUMINUM (ANGLE IRON TYPE) LATH NNE ≈ 1 FT. MONUMENT ON VERY STEEP SE SLOPE ≈ 35 HIGHER THAN AND ≈ 55 FT EAST FROM C OF GRAVEL RD.**

CS 67/54-22  
4/4