

GOVERNMENT CORNER RESTORATION FORM

FILED

TOWNSHIP 26S RANGE 2W SEC. 13 PLSS # 640400

Date: 10/18/2022 By: X

This survey consists of:

DOUGLAS COUNTY OREGON

DATE 10-10-22

Map: _____

Narrative: _____

Corner Rpt: CS 67/54-24

Corner Designation

1/4 COR 13/24

DOUGLAS COUNTY SURVEYOR

Monument(s) Found: (Condition and Source)

2 1/2" DCSD BRASS CAP ON
1" Iron pipe ORIG stone
ON west edge of BRASS CAP

___ Condition report

___ Not Found

Renewed

___ Unrecorded

___ Surveyed In

Previous Renewals

GLD Resurvey 1914 - 1918

Vol 10 pgs 4292 & 4301

DCSD 1961 CS 52/77-5

DCSD 1967 CS 54/40-21

DCSD 1984 CS 62/21-10

MONUMENT DETAIL

County Surveyors
OFFICE

T 26S R2W

1/4 513
4 524

1961

Accessories Found

SINGED 27" I Cedar N 30 1/2° E (Rec N 32 1/2° E)
38.3 FT ADD 3 1/2" MAG Nail RIGHT Side Center

BURNED - SAWN 34" X 3" D. Fire stump S 11° W

50.5 FT (Rec S 12° W 50.7 FT) ADD 3 1/2" MAG Nail
Top Center Healed Double BLAZE

Burnt - DEAD 21" D Fire S 85° W 45.1 FT (Rec
95.1 FT) Fully Healed Double BLAZE

Burnt - DEAD 6" I. Cedar N 46 1/2° W 53.7 FT
BLAZES BURNED AWAY INSIDE OF TREE

2 Alum. Post 0.3 FT EAST AND 0.3 FT SOUTH

C.S. File 67/54-24

Monument Set (Procedure and Description)

MONUMENT DETAIL

Blank lines for Monument Set description.

New Accessories

Blank lines for New Accessories description.


Sketch of Monument, Accessories, and General Area

Location & Comments

Lat $43^{\circ}17'58.76''N$
Long $122^{\circ}52'59.75''W$

CORNER IS APPROX
78' WEST OF BUDY
ROAD & 20' NORTH OF
PRIVATE DRIVE.
AREA BURNED
9-2020
Comp. Decline. $14\frac{1}{2}''E$

Agency DCSD
Party Chief S. FIAUSE
Note keeper
Witnesses J. LORSONG

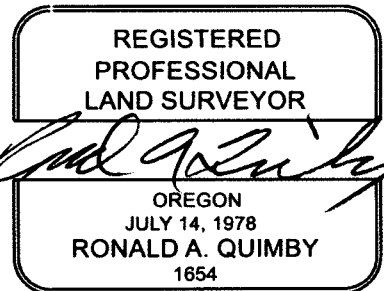

EXPIRES: 12/31/2022

CS 67/54-24
23

10/10/22

TOWNSHIP 26 RANGE 02 POINT IDENTIFIER # 640400

PRIMARY CORNER DESCRIPTION 1/4 Cor. Secs. 13 & 24

Alias _____	Description _____
Alias _____	Description _____
Alias _____	Description _____
Alias _____	Description _____

Douglas Co. Surveyors Office - Randall Smith - Stephen J. Flause - 12/20/1984 - C.S. File 62/21-10

Found - Approx. 5x6x12" stone from 1916 resurvey, mkd "41-"
 Stone set on west edge of brass cap.
 A 1961 brass cap on an IP properly mkd., firmly set & protruding 12" from ground. 1961
 No evidence of orig. SW fir found.
 Orig. Cedar, 8" now a 30" dead & fallen cedar with opened blaze, partial scribing visible. Root hole of this tree bears N.55°E., 9.9 ft.
 No evidence of SW BT fd from 1916 resurvey. A private rd has been built through this location.
 I. Cedar now 27" DBH with a well healed double blaze. No scribing visible bears N.30°E., 38.3 ft. 1961
 D. Fir with a well healed double blaze. No scribing visible, bears S.12°W., 50.5 ft. 1961
 New BT -> An 8" DBH D. Fir scribed 1/4 S24 CS BT on a double blaze bears S.85°W., 95.1 ft.
 I. Cedar scribed 1/4 S13 CS BT on a double blaze bears N.46 1/2°W., 53.7 ft.

NO EVIDENCE REMAINS

BASE SINGED ALIVE 27" - 11"

BURNED SAUN STMP 34" x 3 1/2"

BURNED DEAD 21"

BURNED DEAD STILL 6"

ADD 3 1/2" MAG NAIL RSC

SET 3 1/2" MAG NAIL TOP ENTR.

BLAZES BURNED AWAY INSIDE TREE

Monument lies approx. 75 ft. west of boundary road & approx. 20 ft. north of a private road to the Circle K (K) Ranch.

TWO ALUMINUM LATH FND. 03' EAST AND 03' SOUTH FROM MON.

TYPO - should be 451'

CS 67/54-24

3/3