

GOVERNMENT CORNER RESTORATION FORM

FILED

TOWNSHIP 255 RANGE 3W SEC. 11

PLSS # 600540 Date: 10/24/2022 By: X

This survey consists of:

DOUGLAS COUNTY OREGON

DATE 10-18-22

Map: \_\_\_\_\_

Narrative: \_\_\_\_\_  
Corner Rpt: C&67/54-25

Corner Designation

1/4 COR 11/12

DOUGLAS COUNTY  
SURVEYOR

Monument(s) Found: (Condition and Source)

2 1/2" GLD BRASS CAP ON  
1" IRON PIPE PIPE bent  
badly REPLACED WITH NEW

\_\_\_ Condition report

\_\_\_ Not Found

Renewed

\_\_\_ Unrecorded

\_\_\_ Surveyed In

Previous Renewals

GLD RESURVEY 1940 Vol 27 pg  
11549-50

DCSD 1966 CS 54/27-60

MONUMENT DETAIL

1/4  
S11 / S12  
1943

Accessories Found

1940 RT  
BURNED - BROKEN 30" X 4 1/2' FT FIR STUMP  
S 74 1/2 E 29.7 FT

1966 DCSD RT  
BURNED - SAWN 38" X 1 FT D. FIR STUMP  
S 40 W 19.2 FT (REC 19.4 FT) ADD 3 1/2" MAG  
NAIL TOP CENTER

RENEWAL

Monument Set (Procedure and Description)

MONUMENT DETAIL

3/4" Alum Cap on 2/4" I.D. Alum pipe set at referenced position of old corner

Douglas County Surveyors Office

T255 R3W

1/4 S11/S12

2022

New Accessories

5/8" x 30" Iron Rod with DCSD yellow plastic cap N90E 48.0 FT 4P 4"

5/8" x 30" Iron Rod with DCSD yellow plastic cap N39E 58.4 FT 4P 4"

Steel fence post set 1 FT South

Sketch of Monument, Accessories, and General Area

Location & Comments

ORCS Coordinate Reference system South Zone

PREA BURNT 9-2020

Cottage Grove - Canyonville


N 210320.845

E 249378.517

Comp. Decline. 14 1/2 E

Agency DCSD Party Chief S. F. AUSE

Note keeper Witnesses J. LORSUM

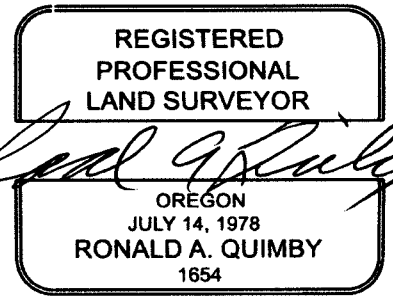

CS 67/54-25

PRIMARY CORNER DESCRIPTION 1/4 Cor. for Secs. 11 and 12

Alias	Description
Alias	Description
Alias	Description
Alias	Description

Original, Laban H. Wheeler, Under Contract #467 dated April 7, 1883 (DCSO Records, Volume 9 Page 3676)

-----

Set Hemlock post, 3 ft. long, 3" sq., 24" in the ground, for 1/4 sec. cor., mkd. 1/4 S on W. face, on ridge, course E. and W. from which

- A Hemlock 6" dia., bears E. 13 lks. dist. mkd. 1/4 S BT.
- A Hemlock 12" dia., bears N.41°W., 14 lks. dist. mkd. 1/4 S BT.

GLO Dependent Resurvey by Norman D. Price, Under Special Instructions dated April, 5, 1940. (DCSO records, Volume 27 Pages 11549-50)

-----

Point for original 1/4 sec. cor. determined by reference to the record measurements from both old bearing trees. At point for corner, set an iron post, 3 ft. long, 1" dia., 28" in the ground, for 1/4 sec. cor., with brass cap mkd.

1/4  
S11|S12  
1943

from which

- A Hemlock 7" dia., bears S.75 3/4°E., 13 lks. dist., mkd. 1/4 S BT. (Old BT)
- A Hemlock 16" dia., bears N.36 1/2°W., 14 lks. dist. with blaze healed. (Old BT)
- A Fir 40" dia., bears S.74 1/2°E., 45 lks. dist., mkd. 1/4 S12 BT. (New BT)
- A Yew 8" dia., bears N.87°W., 47 lks. dist., mkd. 1/4 S11 BT. (New BT)

Doug. County Surveyors Office - Vernon Tracy; Joe Brady; Jack Heritage - July/Aug. 1966 - C.S. File 54/27-60

**FOUND MON. PLUMB POS REFERENCED OUT**

Found - GLO brass cap mkd. "1/4 S11|S12 1943", bent over & buried. We dig up & straighten BC & reset.

**ALL BTs DESTROYED BY LOGGING AND FIRE. SCRIBE VISIBLE ON 40" FIR STUMP, S.74 1/2°E., 29.7 FT.**

New BTs - ~~54~~ DV Fir S.40°W 19.7 ft. mkd. 1/4 S11 CS BT

~~24" Cedar stump S.67°E., 53.3 ft. mkd. 1/4 S12 CS BT. (7 ft. high)~~

Corner lies in old logged and burned area growing up to small fir & hemlock in heavy greasewood & willow brush.

1940 BT  
BURNED BROKEN  
FIR STUMP

BURNED SAWN STUMP  
38" x 1 FT

DEC 14 1/2° E

GONE NO EVID.

36" IR PROJ 4" N 9° E, 48°  
" " " N 39° E, 58°

A FOUND LOOSE STEEL FNC POST SET 1 FT SOUTH OF B.C. MON.

2 1/2" GLO BC AS ABOVE  
PIPE BENT 1 1/2 FT  
EASTLY OFF PLUMB  
MAG TOP CNTR  
NEW MON SET AT REFERENCED POSITION A "DOUGLAS COUNTY SURVEYORS OFFICE"  
ALL ALUMINUM 3/4" CAP ON 2 1/4" I.D. PIPE  
(SEE BACK OF PG. FOR MARKING)

DOUGLAS COUNTY SURVEYOR'S OFFICE

T25 S R3W

1/4  
S11 | S12

2022

CS 67/54-25  
414