

GOVERNMENT CORNER RESTORATION FORM

FILED

TOWNSHIP 25S RANGE 3W SEC. 10

PLSS # 500500

Date: 10/26/2022 By: SC
This survey consists of:

Map: _____

Narrative: _____
Corner Rpt: CS 67/54-27

DOUGLAS COUNTY OREGON

DATE 10-17-22

DOUGLAS COUNTY
SURVEYOR

Corner Designation

Sec. Cor 10/11
15'14

Monument(s) Found: (Condition and Source)

___ Condition report

2 1/2" GLD BRASS CAP ON
1 1/2" I. D. IRON PIPE. STRAIGHTED
TO PLUMB POSITION UP 11"

___ Not Found

Renewed

___ Unrecorded

___ Surveyed In

Previous Renewals

GLD RESURVEY 1940 Vol 27 pg
11559

DCSO 1966 CS 54/27-49

MONUMENT DETAIL

T 25S R 3W

510 | 511
515 | 514

1943

Accessories Found

DCSO 1960 BT'S
BURNED - ROTTED 18" X 2' D. FIR STUMP
N 13° E 10.6 FT

BURNED - SAWN 22" X 1 FT D. FIR STUMP
N 44° W 13.1 FT (REC N 42° W 12.6 FT) NEW
BRING & DIST. TO 3 1/2" MAG. NAIL TOP
CENTER

C.S. File 67/54-27

RENEWAL

Monument Set (Procedure and Description)

MONUMENT DETAIL

New Accessories

BURNED - SAWN 30" X 3 FT D. FIR STUMP
N 22° E 38.0 FT 3 1/2" MAG NAIL TOP CENTER

BURNED - SAWN 28" X 3 1/2 FT D. FIR STUMP
S 23 1/2° E 26.0 FT 3 1/2" MAG NAIL TOP CENTER

Steel Fence Post 1 FT South

Sketch of Monument, Accessories, and General Area

Location & Comments

Oces State Place

Coordinates

Cottage Grove - Canyonville

Zone

N 209974.491

E 245461.055

AREA BURNED
9-2020


Comp. Decline. 14 1/2° E

Agency DCSO

Party Chief S. Elouse

Note keeper

Witnesses J. Lorsung

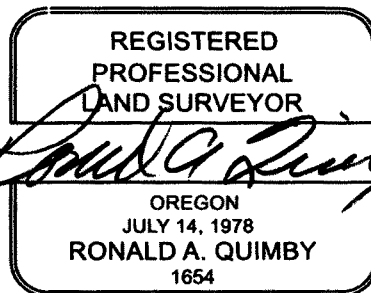

CS 67/54-27

PRIMARY CORNER DESCRIPTION Sec. Cor. for 10, 11, 14 and 15

Alias _____ Description _____
 Alias _____ Description _____
 Alias _____ Description _____
 Alias _____ Description _____

Original, Laban H. Wheeler, Under Contract #467 dated April 7, 1883 (DCSO Records, Volume 9 Page 3686)

 Set Cedar post 4 ft. long, 4" sq., 24" in the ground for cor. to secs. 10, 11, 14 and 15, mkd. T25S S11 on NE., R3W S14 on SE., S15 on SW., and S10 on NW. faces, with 4 notches on S. and 2 notches on E. edges, from which
 A Fir 40" dia., bears N.19°E., 10 lks., mkd. T25S R3W S11 BT.
 A Cedar 18" dia., bears S.25°E., 30 lks., mkd. T25S R3W S14 BT.
 A Fir 6" dia., bears S.41°W., 8 lks. mkd T25S R3W S15 BT
 A Hemlock 8" dia., bears N.69°W., 9 lks., mkd. T25S R3W S10 BT.

GLO Dependent Resurvey by Norman D. Price, Under Special Instructions dated April, 5, 1940. (DCSO records, Volume 27 Page 11559)

 Point for orig. cor. of secs. 10, 11, 14 and 15, determined by reference to the record measurements from the old NE and NW bearing trees. At point for corner, set an iron post, 3 ft. long 2" dia., 28" in the ground, for cor. with brass cap mkd.

T25S R3W	
S10	S11
S15	S14

1943

from which

The shattered remains of a Fir stump, 48" dia., bears N.88°E., 10 lks., on which ax marks were found. (Old BT)
 A Hemlock 10" dia., bears N.16½°W., 9 lks., mkd. T25S R3W S10 BT. (Old BT)
 A Fir 40" dia., bears N.51¾°E., 107 lks., mkd. T25S R3W S11 BT. (New BT)
 A Yew, 8" dia., bears S.31¾°E., 46 lks., mkd. T25S R3W S14 BT. (New BT)
 A Cedar 30" dia., bears S.58°W., 50 lks., mkd. T25S R3W S15 BT. (New BT)
 A Hemlock 12" dia., bears N.6¾°W., 44 lks., mkd. T25S R3W S10 BT. (New BT)

Doug. County Surveyors Office - Vernon Tracy; Joe Brady; Jack Heritage - July/Aug. 1966 - C.S. File 54/27-49

Found - GLO brass cap mkd. 1943, with steel fence post alongside.
 continued next page

2 1/2" BC / 1 1/2" I.D.I.P
PROT 10" LEANING ENE ≈ 1 FT. FROM PLUMB
STRAIGHTEN TO PLUMB POS NOW PROT 11"
CS 67/54-27 34
OVER →

TOWNSHIP 25 RANGE 03 POINT IDENTIFIER # 500500

PRIMARY CORNER DESCRIPTION Sec. Cor. for 10, 11, 14 and 15

Alias _____	Description _____
Alias _____	Description _____
Alias _____	Description _____
Alias _____	Description _____

SEE PG. 1 FOR MONUMENT

BURNED AWAY VERY ROTTED
18" X 2 FT. STUMP
BURNED SAWN FIR STUMP
22" X 1 FT.
POSS. ROOT HOLE

All BTs in very poor condition or gone completely.
Find scribe on 1943 resurvey BT to NE.
New BTs - 5" D. Fir N. 13° E, 10.6 ft. mkd. S11 CS BT - BLZ GONE
4" D. Fir N. 42° W., 12.6 ft. mkd. S10 CS BT - N 44° W, 13' FT TO
7" D. Fir S. 14° W, 16.4 ft. mkd. T25S R3W S15 CS BT. 3 1/2" MAG NAIL TOP OF STUMP
No other trees available.
This cor. lies on very steep slope approx. 300 ft. East of branch of S. Fork of Hinkle Creek in greasewood brush.

NEW REFS

BURNED SAWN 30" X 3 FT. SOLID D. FIR STUMP N 22° E, 38° FT.
" " 28" X 3 1/2 FT " " " S 23 1/2° E, 26° FT.

BOTH STUMPS NOW HAVE 3 1/2" MAG NAIL TOP CONTR.

REPLACE STEEL FNC POST 1 FT SOUTH FROM MON

DECLINATION 14 1/2° E