

TOWNSHIP 245 RANGE ZW SEC. 29 PLSS # 200200

Date: 10/26/2027 By: SC

This survey consists of:

Map: \_\_\_\_\_

DOUGLAS COUNTY OREGON

DATE 10-25-22

Narrative: \_\_\_\_\_  
Corner Rpt: CS67/54-28

DOUGLAS COUNTY  
SURVEYOR

Corner Designation

Sec Cor 30/29  
31/32

Monument(s) Found: (Condition and Source)

2 1/2" BRASS CAP ON 2"  
IRON PIPE UP 14"

\_\_\_ Condition report

\_\_\_ Not Found

Renewed

\_\_\_ Unrecorded

\_\_\_ Surveyed In

Previous Renewals

BLM Resurvey 1951-1963  
Vol 32 pgs 13302-3  
DCSO 1969 CS 54/27-252  
RICE 2012 CS 65/77-36

MONUMENT DETAIL

T245 RZW  
S30/S29  
S31/S32  
1951

Accessories Found

BLM BT  
Burned 46" X 4 FT SAWN FIR STUMP S74°E  
16.5 FT SCAR burnt off  
BT'S by RICE  
Burned - SAWN 22" X 6 FT D. FIR STUMP S33°E  
(Rec S32°E) 6.9 FT  
Burned - SAWN 21" X 6 FT D. FIRE STUMP N70 1/2°E  
(Rec N72°E) 28.1 FT HEALED BLAZE SCAR BURNT  
BURNT. SAWN 25" X 7' D. FIR STUMP N 3 1/2°E  
33.9 FT (Rec N6°E 33.6 FT) HEALED BLAZE GOOD  
SCAR  
Unrecorded 1 1/4" ID IRON PIPE N 8°E 4.7 FT  
UP 15"  
Steel Post EAST 1.0 FT

ALL BTS have 3/4" mag spikes - Top Center spiked if 4ft or less  
Right side center spiked otherwise C.S. File 67/54-28

Monument Set (Procedure and Description)

MONUMENT DETAIL

Horizontal lines for Monument Set description.

New Accessories

Horizontal lines for New Accessories description.

Sketch of Monument, Accessories, and General Area

Location & Comments

CORNER IS ON SMALL bench  
60 FT NORTH OF GRAVEL ROAD

AREA BURNED  
9-2020

OCRS STATE PLANE COORDINATE  
SYSTEM Cottage Grove

CANYONVILLE ZONE

N 223346.965

E 260649.714

Comp. Decline. 14 1/2° E

Agency DCSD


Party Chief S. Fause

Note keeper

Witnesses J. LORSUNY



Ronald A. Quimby

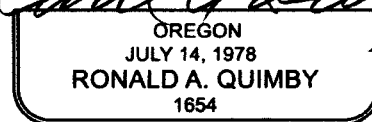

EXPIRES: 12/31/2022

CS 62154-28

MM GPS 10/28/22  
TIME-10:00  
H. 1.54 2.000M

OCT 25, 2022

TOWNSHIP H. 1.54 2.000M RANGE 02 POINT IDENTIFIER # 200200

PRIMARY CORNER DESCRIPTION Cor. Secs 29, 30, 31, & 32

Alias _____	Description _____
Alias _____	Description _____
Alias _____	Description _____
Alias _____	Description _____

New BT - 16" Hemlock S.21°W. 105.2 ft. mkd: T24S R2W S31 CSBT  
 Found - Weyerhaeuser BT: 48" Fir stump S.77°W., 42.9 ft.  
 This also Orig. BT, no scribe fd, badly burned.  
 This corner lies on bench in dense fir reproduction,  
 greasewood & vine maple brush.

Rob Rice, NW Land Surveying - Jason Collier - Sept. 6, 2012 -  
 C.S. File 65/77-36

Found - 2" dia. ~~Iron post with BLM brass cap dated 1951~~ **PROT 14"**  
 48" Fir sawed stump, S.74°E, 16.5 ft., fragmentary  
 scribe on burned blaze. Rescribed ~~"T24S R2W S32  
 CS-BT"~~ (Found with no marks) **SCRIB BURNED OFF**  
 16" Hemlock S.21°W., 105.2 ft. mkd: T24S R2W S31 CS  
 BT (Fd 32" Hemlock with healed face)  
 Weyerhaeuser BT: 48" Fir stump S.77°W., 42.9 ft. (Fd  
 in same condition)  
 New - 20" D. Fir bears S.32°E., 6.9 ft scribed T24S R2W S32 BT  
 BURNED SAWN 21" x 6 FT. STUMP 19" D. Fir bears N.72°E. 28.1 ft scribed T24S R2W S29 BT **PHB SCRIB BURNED**  
 " " 25" x 7 FT STUMP 23" D. Fir bears N.6°E., 33.9 ft scribed T24S R2W S29 BT **PHB SCRIB. GOOD**  
 Note - Corner has steel post adjacent to it. All BTs have  
 orange painted bands and yellow tags.  
 Declination 16° East

**FND. UNRECORDED 1 1/4" I.D IRON PIPE PROT. 15" AND LEANING WESTLY  
 BEARS N08°E 43 FT. DIST.**

**MONUMENT ON SMALL BENCH 60 FT. NORTH FROM GRAVELLED FOREST RD.  
 STEELATH IS EAST 1 FT. FROM BC.**