

GOVERNMENT CORNER RESTORATION FORM

FILED

TOWNSHIP 25S RANGE 3W SEC. 14

PLSS # 500440

Date: 11/1/2022 By: J
This survey consists of:

DOUGLAS COUNTY OREGON

DATE 10-31-22

Map: _____
Narrative: _____
Corner Rpt: CS 67/54-31

DOUGLAS COUNTY
SURVEYOR

Corner Designation

1/4 COR 15/14

Monument(s) Found: (Condition and Source)

GLO BRASS CAP ON 1"
IRON PIPE

- Condition report
- Not Found
- Renewed
- Unrecorded
- Surveyed In

Previous Renewals

GLO Resurvey 1940 Vol. 27 pg
11559
DCSO 1966 CS 54/27-59

MONUMENT DETAIL

1/4
S15/S14
1943

Accessories Found

13" Burnt broken Rotted D. Fir Stump 9 FT
S27°W (Rec S 37°W) 12.3 FT Healed Double Blaze

14" Burnt Broken Rotted 4 1/2' D. Fir Stump
S66°E (Rec S55°E) 15.2 FT Healed Double BLAZE

Steel Fence Post Alongside

C.S. File 67/54-31

RENEWAL

Monument Set (Procedure and Description)

MONUMENT DETAIL

New Accessories


4 5/8 x 30" Iron Rods with DCSO yellow
 Plastic Caps 4" 4"
 North 5.0 FT
 S 16 1/2° E 67.5 FT
 S 2 1/2° W 53.0 FT
 West 5.0 FT

Sketch of Monument, Accessories, and General Area

Location & Comments

CORNER IS ON moderate
 North Slope
 OCRS COORDINATES Cottage
 Grove CANYONVILLE ZONE
 N 207202.237
 E 245378.030

CORNER IS approx
 65 FT North of
 Gravel Spur Road
 AREA Burnt
 9/2020
 Comp. Decline. 14 1/2° E
 Agency DCSO
 Party Chief S. F. AUSE
 Note keeper
 Witnesses J. LORSONG

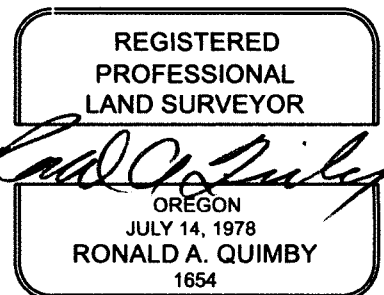

EXPIRES: 12/31/2022

CS 67/54-31

ORCS N1A
H.1. - 2.000 M

RENEWED 10/31/22

TOWNSHIP 25 RANGE 03 POINT IDENTIFIER # 500440

PRIMARY CORNER DESCRIPTION 1/4 Cor. for Secs. 14 and 15

Alias _____	Description _____
Alias _____	Description _____
Alias _____	Description _____
Alias _____	Description _____

Original, Laban H. Wheeler, Under Contract #467 dated April 7, 1883 (DCSO Records, Volume 9 Page 3686)

Set Hemlock post, 3 ft. long, 3" sq., 24" in the ground for 1/4 sec. cor. mkd. 1/4 S on W. face, from which

- A Hemlock 8" dia., bears S.61°E., 16 lks. dist., mkd. 1/4 S BT.
- A Fir 24" dia., bears S.70°W., 57 lks. dist., mkd. 1/4 S BT.

GLO Dependent Resurvey by Norman D. Price, Under Special Instructions dated April, 5, 1940. (DCSO records, Volume 27 Page 11559)

Point for original 1/4 sec. cor., determined by reference to the record measurement from both old bearing trees. At point for corner, set an iron post, 3 ft. long, 1" dia., 28" in the ground, for 1/4 sec. cor., with brass cap mkd.

1/4
S15|S14
1943

from which

- A dead Hemlock 18" dia., bears S.38 1/2°E., 16 lks., with blaze healed. (Old BT)
- A Fir 28" dia., bears S.15 1/2°W., 57 lks., mkd. on bark 1/4 S BT. (Old BT)
- A Fir 30" dia., bears N.77°E., 220 lks., mkd 1/4 S14 BT. (New BT)
- A Hemlock 20" dia., bears S.60 1/2°W., 120 lks., mkd. 1/4 S15 BT. (New BT)

Doug. County Surveyors Office - Vernon Tracy; Joe Brady Jack Heritage - July/Aug. 1966 - C.S. File 54/27-59

Found - 1943 Brass cap mkd. 1/4 15|14 1943, with steel fence post alongside.

All BTs are stumps except orig. SE. Scribe found on 1943 BT to SW.

BURNED BROKEN ROTTED 13" x 4 FT. STUMP
BURNED BROKEN ROTTED 14" x 4 1/2 STUMP

New BTs
 D Fir S. 37° W., 12.3 ft. mkd. 1/4 S15 CS BT. FHDB
 D Fir S. 55° E., 15.2 ft. mkd. 1/4 S14 CS BT. FHDB

Corner lies in old logged unit now covered with very dense reproduction of D. Fir, Hemlock and Cedar.

DECLINATION 14 1/2° E
566° E

NEW REFS

- 5/8" x 30" 15" NEW LOG STAMP PROT 4" NORTH, 50 FT.
- " " " " S16 1/2° E, 67 1/2 FT.
- " " " " S02 1/2° W, 53° FT
- " " " " WEST, 50 FT

CS62/54-31
3/3

MON. ON MODERATE NORTH SLOPE ≈ 65 FT NORTH OF GRAVELED CURB RD