

DOM# 850

FIND OR 8/5/21

TOWNSHIP 23 RANGE 08 POINT IDENTIFIER # 677100

PRIMARY CORNER DESCRIPTION NE Cor Sec 1, T24-8

Alias \_\_\_\_\_ Description \_\_\_\_\_  
 Alias \_\_\_\_\_ Description \_\_\_\_\_  
 Alias \_\_\_\_\_ Description \_\_\_\_\_  
 Alias \_\_\_\_\_ Description \_\_\_\_\_

GLO Survey by Henry L. Chandler, U.S. Deputy Surveyor, under Contract #619, dated June 5, 1893 - (DCSO records Vol. 8 Page(s) 3225)

At point of intersection, I set a post 4½ ft. long, 4" sq., 24" in the ground for closing cor. to T24S Rs. 7 and 8, marked CC T24S on S.; R7W S6 on E.; and R8W S1 on W. faces, with 6 notches on S., E., and W. faces, from which

A Fir 36" dia., bears S.57°E., 83 lks. dist. mkd. T24S R7W S1 BT.

A Fir 48" dia., bears S.57°E., 120 lks. dist. mkd. T24S R8W S1 BT.

A Fir 36" dia., bears N.38°W., 85 lks. dist. mkd. T24S Rs. 7 & 8 BT.

Douglas Co. Surveyors Office - James Byron, Deputy - Milo Godfrey; Clete Putnam, crew - Sept. 1960 - C.S. File 49/41-47

FILED

Found - Orig. 36" now 48" Fir, N.38°W., 56.1 ft., old face destroyed by fire.

Found - Orig. 36" now 42" Fir, S.57°E., 54.8 ft., old face destroyed by fire.

Found - Orig. 48" now 65" Fir S.10°W., (Rec. S.57°E.) 79.2 ft., now stump shows rotted face.

Found - Brass cap at cor. mkd: County Surveyors Office

C	C	T23S
S	1   S	6 T24S
R8W	R7W	
1960		

New BTs- 3" R.Fir bears S.13°W., 15.4 ft. scribed S1 CS BT. Rescribe, now 42" R.Fir S.57°E., 54.8 ft. CC S6 T24S R7W CS BT.

Douglas County Surveyors Office - Vernon "Ray" Tracy and crew Wit: B. Bright and T. Watts, BLM - April 18, 1966 - C.S. File 49/41-58

Found - DCSO brass cap, properly mkd. as recorded. All BTs down and dead or gone completely.

New BTs- 8" W.Fir, East 32.8 ft, mkd. CC T24S R7W S6 CS BT. 6" D.Fir S.53°W., 74.2 ft. mkd. CC S1 CS BT.

Corner lies 30 ft. South of old logging road.

Survey by Les Roberts - For: International Paper Co. - 1979 -M 80-47

Set 1½" I.Pipe and brass cap at true intersection, from which (Cont. Next Page)

C.S. FILE 67/54-45<sup>1</sup>

**FILED**  
 Date: 11/3/2022 By: [Signature]  
 This survey consists of:  
 Map: \_\_\_\_\_  
 Narrative: \_\_\_\_\_  
 Corner Rpt: CS 67/54-45  
**DOUGLAS COUNTY SURVEYOR**

TOWNSHIP 23 RANGE 08 POINT IDENTIFIER # 677100

PRIMARY CORNER DESCRIPTION NE Cor. Sec. 1, T24-8

Alias \_\_\_\_\_ Description \_\_\_\_\_  
Alias \_\_\_\_\_ Description \_\_\_\_\_  
Alias \_\_\_\_\_ Description \_\_\_\_\_  
Alias \_\_\_\_\_ Description \_\_\_\_\_

12" Fir bears S.62°W., 64.1 ft.  
8" Fir bears S.55°E., 11.2 ft.  
Corner lies 2.28 ft. South of corner set by the County.

Douglas Co. Surveyors Office - Larry E. Monrean, Deputy -  
Randall Smith and Stephen Flause, crew - March 5, 1984 - C.S.  
File 62/16-7

-----  
Found - I.P. with properly mkd. brass cap protruding 12".  
I.P. with properly mkd. brass cap protruding 8".  
8" now 17" W. Fir with well healed double blaze bears  
East. 32.8 ft. (DCSO 1966)  
6" now 11" D. Fir with well healed single blaze bears  
S.53°W., 74.2 ft. (DCSO 1966)  
12" Fir with partially healed double blaze with  
visible scribing "T24", bears S.62°W., 64.1 ft.  
(1979)  
8" Fir with partially healed double blaze, with  
visible scribing "BT", bears S.55°E., 11.2 ft.  
(1979)

The letters "AM" were added to the DCSO closing corner cap.  
(Sketch in C.S. File)

BLM Dependent resurvey by A. Bert Skeesick, Cadastral  
Surveyor and Robert H. Browning, Survey Tech, under special  
instructions and Group No. 2104, surveyed July 2005/Jan. 2006  
(DCSO records Vol. 57 Page(s) 22401-2)

-----  
The true point for the closing cor. of secs. 1 and 6, at the  
intersection with the township line, established by Roberts,  
in 1979, and is accepted as the cor., monumented with an iron  
post, 2" dia., firmly set, projecting 9 ins. above ground,  
with brass cap (properly) mkd.

from which bearing trees mkd. by Roberts

A fir, 14" dia., bears S.57°E., 11.3 ft., with a healed  
double blaze.

A fir, 23" dia., bears S.61½°W., 64.1 ft., with a healed  
double blaze.

From this point, the orig. closing cor. of secs. 1 and 6,  
T24S Rs 7 & 8W., established by Chandler in 1893,  
remonumented by the Douglas County Surveyors Office in 1960,  
and perpetuated by the Douglas County Surveyors Office in  
1966 and 1984, bears N.0°08'01"E., 2.17 ft., monumented with  
an iron post, 1½" dia., firmly set, projecting 14" above  
ground, with brass cap (properly) mkd.

from which the remains of the orig. bearing trees

A decayed fir stump, size indeterminate, bears S.57°E.,  
54.8 ft., with no marks visible continued next page

CS 62/54-45

TOWNSHIP 23 RANGE 08 POINT IDENTIFIER # 677100


PRIMARY CORNER DESCRIPTION NE Cor. Sec. 1, T24-8

Alias _____	Description _____
Alias _____	Description _____
Alias _____	Description _____
Alias _____	Description _____

A sawed fir stump, 50" dia., bears S.9¼°W., 77.2 ft., with no marks visible. (Record, S.12°W., 79.2 ft.) and bearing trees mkd. by the Douglas County Surveyors Office in 1966

A fir, 28" dia., bears N.88¾°E., 32.6 ft., with a healed blaze.

A fir, 20" dia., bears S.52¼°W., 73.0 ft., with a healed blaze.

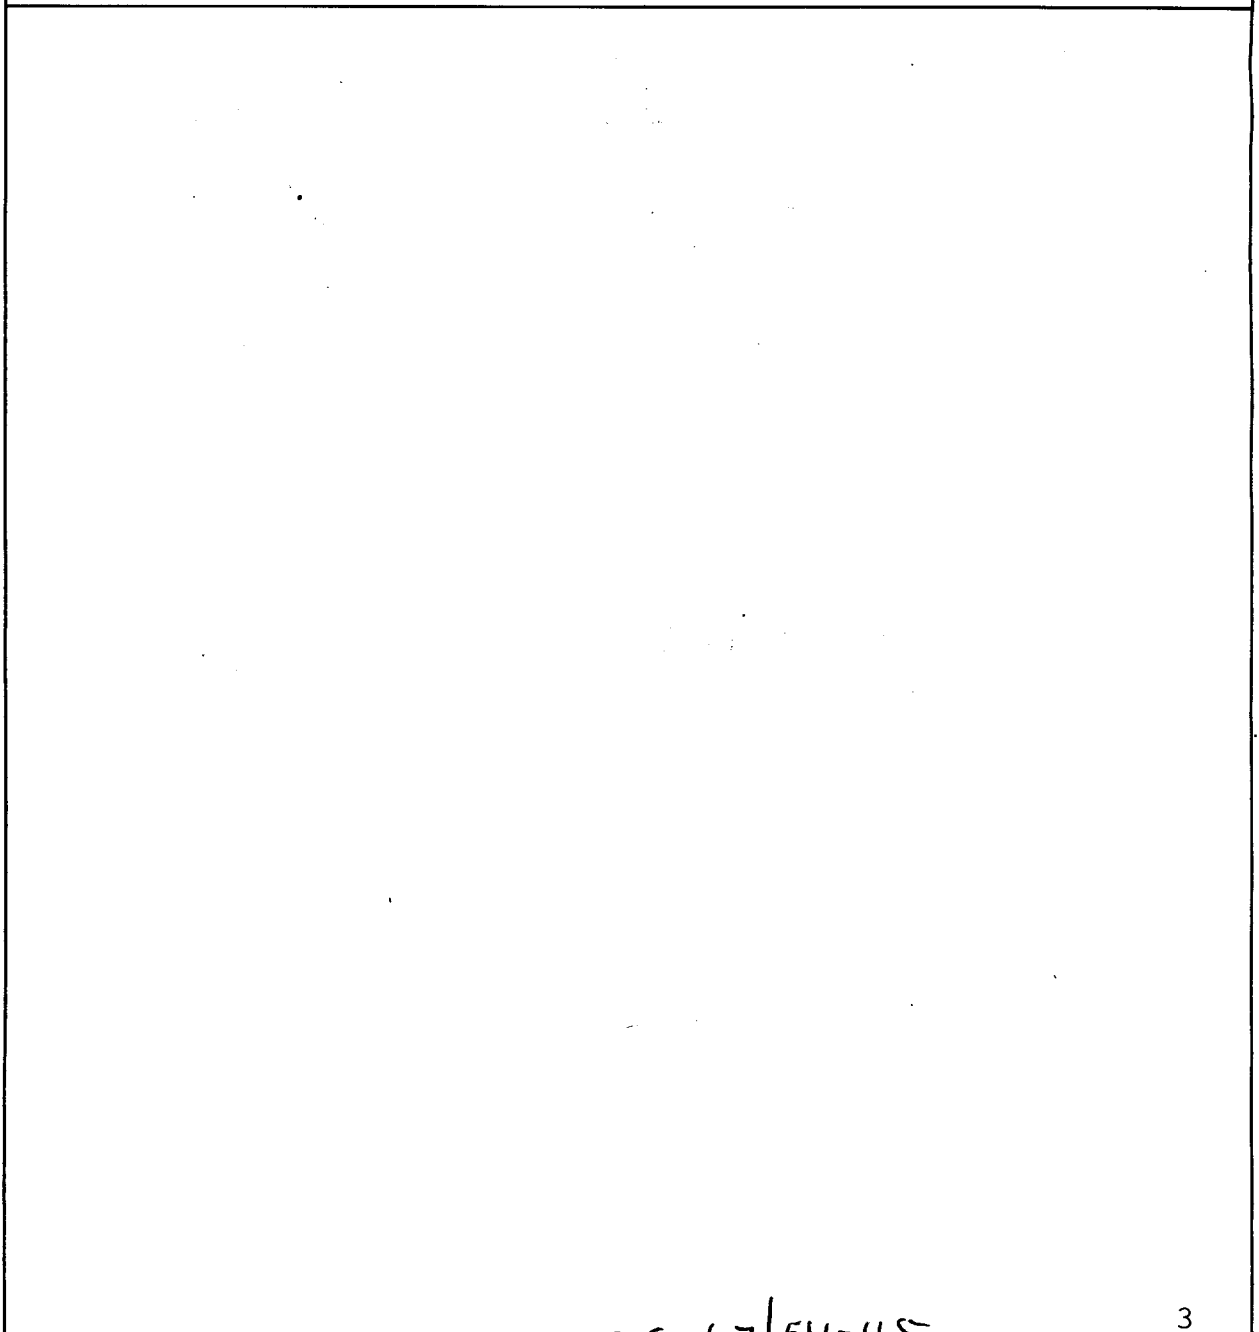

CS 67/54-45