

GOVERNMENT CORNER RESTORATION FORM

FILED

TOWNSHIP 25S RANGE 3W SEC. 1

PLSS # 600400 Date: 11/3/2022 By: JC
This survey consists of:

DOUGLAS COUNTY OREGON

DATE 11-2-22

Map: _____

Narrative: _____
Corner Rpt: CS67/54-47

DOUGLAS COUNTY
SURVEYOR

Corner Designation

see COR 2/1
11/12

Monument(s) Found: (Condition and Source)

2 1/2" BRASS CAP ON 1 1/2"
LD. IRON PIPE UP 14"

___ Condition report

___ Not Found

Renewed

___ Unrecorded

___ Surveyed In

Previous Renewals

GLD RESURVEY 1940 Vol 27
pg 11550
DGSO 1966 CS 54/27-40

MONUMENT DETAIL

T25S R3W
52/51
511/512
1943

Accessories Found

Burnt SAWN 26" X 5 1/2 FT Hemlock STUMP
N 34 1/2° W (Rec N 32 1/2° W) 126.6 FT DEEP SCAR
FACE BURNED

C.S. File 67/54-47

New Accessories

- 14" X 3 FT FIR STUMP N 78° E 15.0 FT 3 1/2"
P.K. NAIL Top Center
- 20" X 2 FT FIR STUMP S 63° E 23.3 FT 3 1/2"
PK NAIL Top Center
- 13" X 1 FT FIR STUMP S 69° W 8.9 FT 3 1/2"
P.K. NAIL Top Center
- 13" X 1 FT FIR STUMP N 12° W 15.0 FT 3 1/2"
P.K. NAIL Top Center

Metal T. Post 1 FT South

Sketch of Monument, Accessories, and General Area

Location & Comments


OCRS Coordinate System
Cottage Grove - Canyonville
Zone

AREA BURNED
9/2020

N 213209.049
E 249411.351

Comp. Decline. 14 1/2° E
Agency DCSO
Party Chief S. F. HAUSE
Note keeper
Witnesses J. LOSUNG

CS 67/54-47

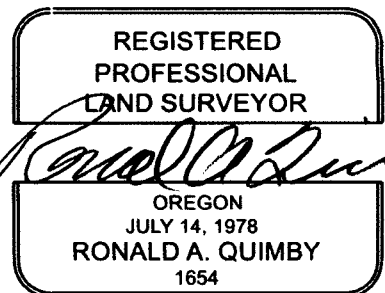

EXPIRES: 12/31/2022

TOWNSHIP 25 RANGE 03 POINT IDENTIFIER # 600600

11-2-22

PRIMARY CORNER DESCRIPTION Sec. Cor. for 11 and 12

Alias _____	Description _____
Alias _____	Description _____
Alias _____	Description _____
Alias _____	Description _____

Doug. County Surveyors Office - Vernon Tracy; Jack Heritage
Aug. 1966 - C.S. File 54/27-40

2" B.C. PROTECTOR MARKED ON 1/2" ID IR PROT 14"

Found - GLO brass cap 1943, & stumps of 1943 BTs. All are
N 34 1/2° W cut too low, or scribe burned off.

BURNED SAWN

GONE - New BTs - 6" Maple N. 60° E., 44.4 ft. mkd. S1 CS BT.

GONE - 26" x 5 1/2" STUMP - 14" Hemlock N. 21° W., 12.6 ft. mkd. T25S R3W S2 CS BT

GONE - Remark stump of 1943 BT 15" Yew stump N. 8 1/2° W., 21.8 ft. "T25S R3W S2 CS BT"

*DEEP SCAR
TRAIL BURNED*

No other trees available.

Corner lies on steep west slope approx. 100 ft. W. of top of mountain.

14" x 3 FT TALL FIR STUMP, N 78° E 15 1/2 FT
 20" x 2 FT TALL FIR STUMP, S 63° E 23 3/4 FT
 13" x 1 FT " " " S 69° W 15 FT 8 1/2
 13" x 1 FT " " " N 12° W 15 FT

METAL T POST 1 FT SOUTH

CS 67/54-47

PRIMARY CORNER DESCRIPTION Sec. Cor. for 1, 2, 11 and 12

Alias _____	Description _____
Alias _____	Description _____
Alias _____	Description _____
Alias _____	Description _____

Original, Laban H. Wheeler, Under Contract #467 dated April 7, 1883 (DCSO Records, Volume 9 Page 3677)

 Set Cedar post, 4 ft. long, 4" sq., 24" in the ground for cor., mkd. T25S S1 on NE., R3W S12 on SE., S11 on SW., and S1 on NW., faces with 5 notches on S. and 1 notch on E. edges, from which

- A Fir 24" dia., bears N.35°E., 25 lks. dist. mkd. T25S R3W S1 BT.
- A Fir 48" dia., bears N.60°W., 13 lks. dist., mkd. T25S R3W S2 BT.
- A Hemlock 6" dia., bears S.75°W., 16 lks. dist., mkd. T25S R3W S11 BT.
- A Fir 10" dia., bears S.31°E., 54 lks. dist., mkd. T25S R3W S12 BT.

GLO Dependent Resurvey by Norman D. Price, Under Special Instructions dated April, 5, 1940. (DCSO records, Volume 27 Page 11550)

 Point for original cor. of secs. 1, 2, 11 and 12, determined by reference to the record measurements from the old NE. and NW. bearing trees. At point for corner, set an iron post, 3 ft. long, 2" dia., 28" in the ground, for cor., with brass cap mkd.

T25S R3W
 S2|S1
 S11|S12
 1943

from which

- A stump hole, bears N.30°E., 25 lks. dist. (The old BT which stood in this position has slid down the mountain and is practically demolished)
- A stump hole, bears N.60°W., 13 lks. dist. (The old BT which stood in this position has slid down the mountain about 2.50 chains. The old surface scar and ax marks are visible but inaccessible on the under side of this uprooted fir tree which is 58" dia.)
- A Hemlock 30" dia., bears N.30 3/4°E., 88 lks. dist., mkd. T25S R3W S1 BT. (New BT)
- A Yew 9" dia., bears S.29°E., 46 lks. dist., mkd. T25S R3W S12 BT. (New BT)
- A Fir 28" dia., bears S.53 1/2°W., 43 lks. dist., mkd. T25S R3W S11 BT. (New BT)
- A Yew 12" dia., bears N.8 1/2°W., 33 lks. dist., mkd. T25S R3W S2 BT. (New BT)

CS 67/54-47
 414