

# CORNER RENEWAL

DATE 7/29/21

RENEWAL STATUS RENEWAL T-R-PLSS T22S, RBW, 200120

MONUMENT FOUND:  
FROM 1963  
BLM RESURVEY

A 3 1/4" DIA. BRASS CAP MARKED AS DESCRIBED  
ON A 2" I.D. IRON PIPE PROJECTS 3" ABOVE GROUND.

## NEW BEARING OBJECTS

A 38" DIA. D. FIR SCRIBED "X" "BT" ON HIGH-LOW  
BLAZES : BEARS S5°E, 43<sup>9</sup> FT. DISTANT

A 37" DIA. N. FIR SHOWING HEALED HIGH-LOW BLAZES  
(GOOD SCARS BUT NO RECORD): BEARS S81°W, 3<sup>9</sup> FT. DISTANT

## HISTORICAL OBJECTS

1963 O.B.T.

A 24" DIA., 1 FT. TALL D. FIR STUMP WITH NO REMAINING  
BLAZE EVIDENCE: BEARS S27 1/2°W, 25<sup>7</sup> FT. DISTANT.

FILED

Date: 11/8/2022 By: SC

This survey consists of:

Map: \_\_\_\_\_

Narrative: \_\_\_\_\_


Corner Rpt: CS 67/54-58

DOUGLAS COUNTY  
SURVEYOR

LOCATION AND COMMENTS

CORNER MONUMENT IS AT TOP OF SMALL CUT BANK ON NORTH EDGE OF LOGGING RD. AREA IS RELATIVELY FLAT BENCH WITH OLD GROWTH FIR SOME NEW LOGGING TO NE.

SKETCH

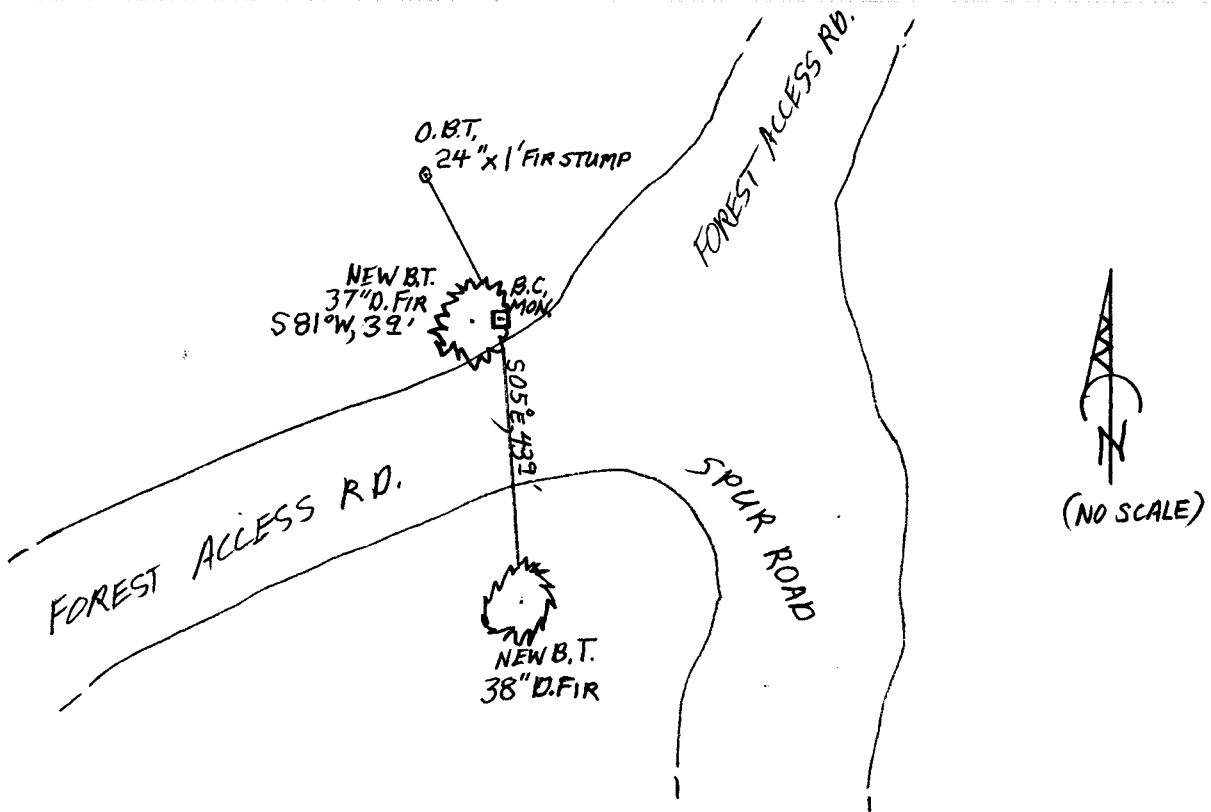

DECLINATION:  $14\frac{3}{4}^{\circ}E$

CREW: CREW CHIEF - S.J. FLAUSE  
TECHNICIAN - J.A. LORSUNG

COORDINATES:

County Surveyor's Record, Douglas County, Oregon

13701  
13701 7/29/21

Dependent Resurvey, Portion Subdivisional Lines, T. 22 S., R. 8 W.

CHAINS

From the cor. of secs. 31 and 32, on the S. bdy. of Tp., heretofore described.

N. 1° 10' E., bet. secs. 31 and 32.

Ascend 260 ft. over SE. slope, through heavy timber and dense undergrowth.

19.95 Gravel road, 25 lks. wide, bears N. 50° E. and S. 50° W.

20.15 Point for the S 1/16 sec. cor. of secs. 31 and 32.

Set an iron post, 28 ins. long, 2½ ins. diam., 24 ins. in the ground, with brass cap marked

PROV 3" S 1/16 S 31 S 32 1963

NEW ACC.  
38" FIR "X" BT S 5° E, 439  
37" FIA PREVIOUS 581° W 39  
H1 - LO HEAD 39

from which

GONE A fir, 5 ins. diam., bears S. 61½° E., 93½ lks. dist., mkd. S 1/16 S32 BT.

SAWN STAMP 24" X 1 FT. TALL A fir, 10 ins. diam., bears N. 27½° W., 39 lks. dist., mkd. S1/16 S31 BT.

Ascend 30 ft. over broken SE. slope.

29.05 Spur, slopes NE.; desc. 210 ft. over N. slope.

31.55 Same gravel road, bears E. and W.

33.70 Creek, 2 lks. wide, course N. 65° E.; asc. 100 ft. over SE. slope.

40.30 The ¼ sec. cor. of secs. 31 and 32, monumented with an iron post, 2½ ins. diam., 4 ins. above ground, firmly set, mkd. and witnessed as described in the official record of the 1960 resurvey.

Land, mountainous.

Soil, rocky and sandy.

Timber, fir, hemlock, cedar, maple, oak, alder, madrone, and cascara; undergrowth, fern, hazel, poison oak, salal, and bunch grass.

From the cor. of secs. 16, 17, 20, and 21.

N. 86° 35' W., bet. secs. 17 and 20.

Descend slightly across open pasture land.

7.25 Woven wire fence, bears N. 30° E. and S. 30° W.

7.29 Point for a witness point on line bet. secs. 17 and 20.

Set an iron post, 28 ins. long, 2½ ins. diam., 21 ins. in the ground, with brass cap marked

WP S 17 S 20 1963

7.40 Henderer Road, graveled, 25 lks. wide, bears N. 30° E. and S. 30° W.

7.65 Woven wire fence, bears N. 30° E. and S. 30° W.

66  
4  
264

MM GPS

H = 10:40

H1 = 0.8925 M

55  
196

25 L

3/3

CS 67/54 - 58