

GOVERNMENT CORNER RESTORATION FORM

FILED

TOWNSHIP 25S RANGE 2W SEC. 2 PLSS # 500600

Date: 11/14/2022 By: XC
This survey consists of:

DOUGLAS COUNTY OREGON

DATE 8-8-22

Map: _____

Narrative: _____
Corner Rpt: CS/67/55-1

Corner Designation

DOUGLAS COUNTY
SURVEYOR

See COR 3/2
10/11

Monument(s) Found: (Condition and Source)

___ Condition report

2 1/2" GLD BRASS CAP ON

___ Not Found

1 3/4" I.D. IRON PIPE UP

Renewed

12"

___ Unrecorded

Previous Renewals

___ Surveyed In

BLM RESURVEY 1951-1963 Vol

32 pg 13345

Juliano 1976 CS 58/130-1

LANG 1992 M114-57

Smalley 2003 65/45-29

MONUMENT DETAIL

T25S R2W

53/52

510/511

1951

Accessories Found

ORIG BT

53" X 3' SAWN FIR STUMP N57°W 40.3 FT

Fully healed BLAZE

Smalley BT'S

8" Burnt-Dead Hemlock S60°W 8.1 FT

Fully Healed BLAZE

2' Tall Mostly burnt away Hemlock S27°E

12.3 FT FACE burnt

13" X 1 FT Shattered Hemlock stump

S56°E 20.1 FT FACE burnt

C.S. File 67/95-1

New Accessories

7" D. Fir 545°E 10.0 FT Scribed T255
 R2W 511 BT

9" Hemlock 583°W 23.1 FT Scribed T255
 R2W 510 CSBT

5/8" X 30" Iron Rod with plastic cap
 Doug. Co. Surveyor South 12.0 FT


Sketch of Monument, Accessories, and General Area

Location & Comments

Lat. 43°25'02.41" N
 Long 122°54'50.12" W.

MON. 13 ON North
 Slope 12' North
 of Ridge Top 28'
 North of Gravel
 Road
 AREA BURNED
 9-2020
 Comp. Decline. 14 1/2° E

Agency DCSD
 Party Chief S F HAUSE
 Note keeper
 Witnesses J LORSUNG

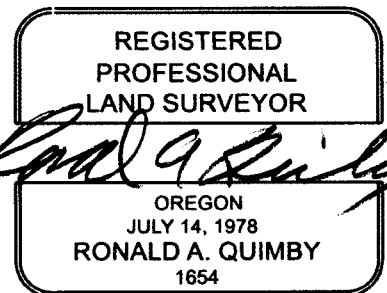

EXPIRES: 12/31/2022

CS 67/55-1
 214

GPS 8/8/22
TIME-12:00
H.I. - 2.000M

REVISITED 8/8/22

TOWNSHIP 25 RANGE 02 POINT IDENTIFIER # 500600

PRIMARY CORNER DESCRIPTION Cor. Secs. 2, 3, 10, & 11

Alias _____	Description _____
Alias _____	Description _____
Alias _____	Description _____
Alias _____	Description _____

Mark Smalley, Roseburg Forest Products - Crew: Bill Olson & Mike Fromdahl - 4/29/2003 - C.S. File 65/45-29

Found - 1951 GLO IPBC (properly marked)

51" Fir N.57°W., 40.3 healed. FHB

New BTs - 6" Hemlock S.60°W., 8.1 scribed "S10 BT" FHB

8" Hemlock S.27°E., 12.8 scribed "S11 BT" FHB FACE NOW GONE

10" Hemlock S.56°E., 20.1 scribed "S11 BT" FHB

13" x 1" SHATTERED STMP

New BTs

7" D. FIR T255 R2WS11" "BT" S45°E, 10² FT

5/8" IR WITH 1" ALS CAP "DOUG. CO. SUPEROR" SOUTH, 12² FT

9" HEMLOCK "T255 R2WS10" "CSBT" S83°W, 23¹ FT

BC ON MON. NORTH SLOPE 12' NORTH OR RIDGE TOP
28' NORTH OF GRAVEL RD.

~~_____~~ N 43° 26' 02.41"
W 122° 54' 50.12"

8" BURNED DEAD
DEAD
NOW 2 FT TALL
MOSTLY BURNED
AWAY SNAG

BURNED
DEAD
BUT INTACT

2 1/2" BC (PROPERLY MK'D ON) 1 3/4" IDIP
PROT. 12"

" " "

MM GPS 8/8/22
TIME - 12:00
H.I. - 2.000M

7/8/20

TOWNSHIP 25 RANGE 02 POINT IDENTIFIER # 500600

PRIMARY CORNER DESCRIPTION Cor. Secs. 2, 3, 10, & 11

Alias _____	Description _____
Alias _____	Description _____
Alias _____	Description _____
Alias _____	Description _____

GLO Survey by Hezekiah H. Johnson, under Contract #721, dated May 1, 1900 (DCSO records Vol. 9 Page(s) 3612)

Set a fir post 3 ft. long, 4" sq., 24" in the ground for cor. of secs. 2, 3, 10, & 11 marked T25S S2 on NE, R2W S11 on SE, S10 on SW & S3 on NW faces with 5 notches on S & 2 notches on E edges, from which

- A hemlock, 6" dia., bears N.51°E., ²¹⁷⁸33 lks., mkd: T25S R2W S2 BT.
- A chinquapin, 4" dia., bears S.47°E., ¹⁸⁴⁸28 lks., mkd: T25S R2W S11 BT.
- A rhododendron, 6" dia., bears S.75°W., ⁸⁵⁸13 lks., mkd: T25S R2W S10 BT.
- A fir, 24" dia. bears N.56°W., ³⁸⁹⁴59 lks. mkd: T25S R2W S3 BT

BLM dependent resurvey Levi E Tallett, Cadastral Engineer (1951) and C. Albert White, Cadastral Surveyor (1963), under Group # 294, surveyed May 1951 - Aug 1963 - (DCSO records Vol. 32 Page 13345)

The cor. of secs. 2, 3, 10, & 11, determined at record distance from the remaining original bearing trees:

- A hemlock, 12" dia., bears N.51½°E., 33 lks., blaze healed. (Record bearing, N.51°E.) The blaze has been chopped out showing scribe marks 2R 5W S2.
- A chinquapin, 5" dia., bears S.47½°E., 28 lks., blaze rotted, partial scribe marks visible. (Record bearing, S.47°E.)
- A fir, 36" dia., bears N.57°W., 61 lks., blaze healed. (Record: bears N.56°W., 59 lks.)

At the corner point

Set an iron post, 36" long, 2" dia., 28" in the ground, with brass cap mkd.

2 1/2" BC T25S R2W
ON 13/4 10/P S 3|S 2 ✓ *PROV. 12"*
 S 10|S 11
 1951

from which

- NF* A hemlock, 14" dia., bears N.64°E., ²¹⁷⁸33 lks., mkd. T25S R2W S2 BT.
- NF* A hemlock, 10" dia., bears S.35½°E., ²¹¹²32 lks., mkd. T25S R2W S11 BT.
- A hemlock, 12" dia., bears S.51½°W., ⁷⁹²⁰120 lks., mkd. T25S R2W S10 BT.

Fd. Ok by Nick Juliano, 12/1976 - C.S. File 58/130-1
Fd. Ok by G. Lang, 2/1992 - M114-57

continued next page

CS 67/551
4/4