

GOVERNMENT CORNER RESTORATION FORM

FILED

TOWNSHIP 26S RANGE 2W SEC. 533 PLSS # 400140

Date: 11/14/2022 By: X

This survey consists of:

DOUGLAS COUNTY OREGON

DATE 9-29-22

Map: _____

Narrative: _____

Corner Rpt: 667/55-3

DOUGLAS COUNTY SURVEYOR

Corner Designation

1/4 COR 533/534

Monument(s) Found: (Condition and Source)

___ Condition report

2 1/2" Alum. Cap up 12"

___ Not Found

ADD Rough Stone MOUND

Renewed

AROUND BASE

___ Unrecorded

Previous Renewals

___ Surveyed In

GLO Resurvey 1916-1918

Vol 10 pg 4311-12

Shrum 1979 M 76-56

BLM Resurvey 1979 Vol 44 pg 14940

SHANER 2001 CS 65/36-2C

M132-70

MONUMENT DETAIL

RE 4287

1/4 COR

T26S 533/534

R2W

1978

Accessories Found

ORIG. BT

BURNED - SAWN 12" X 3 FT FIR STUMP 564°W
37.5 FT (Rec 567°W 38.3) ADD 3 1/2" MAG NAIL

Top Center

Shrum BT

Very Burnt 11" X 12 FT FIR SWAG 525°E
(Rec 520 1/2 E) 28.6 ADD 3 1/2" MAG NAIL

RIGHT Side Center Blaze Gone

C.S. File 67/55-3

New Accessories

37" D. FIR N 2 1/2° E 33.5 FT 3 1/2" MA9
 NAIL RIGHT Side Center
 19" E. Cedar N 59° E 34.8 FT 3 1/2" MA9
 NAIL RIGHT Side Center
 25" D. FIR S 4 1/2° W 34.5 FT 3 1/2" MA9
 NAIL RIGHT Side Center

Note: All Trees Alive BASE BARK Burned

Sketch of Monument, Accessories, and General Area


Location & Comments

OCRS Coordinate System
 Cottage Grove - Canyonville
 Zone NAD 1988
 N 157325.148
 E 271159.790

Cor 15 on moderate
 S.E. slope 175'±
 North of Gravel
 Road

AREP Burd +
 9-2020

Comp. Decline. 14 1/2° E
 Agency DCSO
 Party Chief S. F. AUSE
 Note keeper
 Witnesses J. LORSUNG

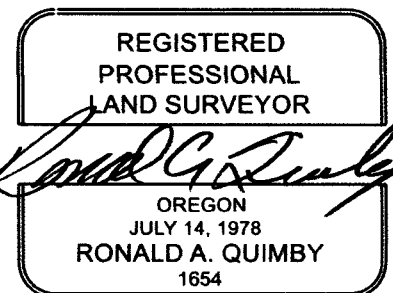

EXPIRES: 12/31/2022

CS 67/55-3

MM GPS 9/28/22

RENEWED 9/29/22

TIME-13:03

H1-2,000M

TOWNSHIP 26 RANGE 02 POINT IDENTIFIER # 400140

PRIMARY CORNER DESCRIPTION 1/4 Cor Secs 33 & 34

Alias _____	Description _____
Alias _____	Description _____
Alias _____	Description _____
Alias _____	Description _____

GLO survey by Wm. N. Gibb, Deputy Surveyor, under contract No. 783, dated Dec. 3, 1908 - (DCSO records Vol 10 Page 4231)

Set fir post, 3 ft. long, & 4" sq., 24" in the ground for the 1/4 sec cor marked 1/4 S 33 on W face & 34 on E face, from which:
 A cedar, 14" dia., bears S.79°E., 33 lks., mkd: 1/4 S34 BT.
 A fir, 14" dia., bears S.64°W., 58 lks., mkd: 1/4 S33 BT.

GLO resurvey by Fred Mensch, U.S. Cadastral Engineer; under Instructions dated May 25, 1916 & April 16, 1918, - (DCSO records Vol. 10 Page(s) 4311-2)

1/4 sec. cor., established by Deputy Gibb in 1909, which is a fir post, 4" sq. 12" above ground, marked & witnessed as described by the survey general.

Thomas E. Shrum, Jr. - For: Champion International Co. - Feb. 1, 1979 *OK*

Found - 24" D.Fir, S.64°W., 38.3 ft.
 Set - 2 1/2" alum cap.
 BT - 18" D.Fir S.26°E., 28.6 ft.
 Note - 1/4 Cor. set from BT established by Gibb in 1909

BLM Dependent resurvey by Wayne Rogers, Cadastral Surveyor, under Group #990, surveyed Aug/Sept 1979 - (DCSO records Vol. 44 Page(s) 16940)

The 1/4 sec. cor. of secs. 33 & 34, perpetuated and recorded by Shrum, in 1978, monumented with an iron pipe, 3/4" dia., firmly set, projecting 6" above ground, with aluminum cap mkd.

DECLINATION 14 1/2° E 2 1/2" ALUM CAP 1/4 COR V RE 4287
 T26 S S 33 | S 34
 R 2 W
 1978

from which the remains of an original BT
 A fir, 22" dia., bears S.67°W., 58 lks., with scribe marks
 BT visible on opened blaze. (Record, S.64°W.)
 and a BT mkd. by Shrum 25° 28.6 FT.

VERY BURNED SNAG 11" X 11 FT. TALL
 BURNED SAWN STUMP 12" X 3 FT. TALL
 ADD 3 1/2" MAGNAIL TOP CENTER
 ADD 3 1/2" MAGNAIL RSC

ADD ROUGH STONE MOUND AROUND BASE
 BURNED P.O.B.
 56 1/2" W 37 1/2 FT.
 BLZ. GONE
 ADD 3 1/2" MAGNAIL RSC

Fd. Ok by B. Shaner, 1/2001 - C.S. File 65/36-2C & M132-70

NEW REFS: ALL LIVE TREES BASE BARK BURNED
 NOT BLZD OR SCRIBED ADD 3 1/2" MAGNAIL R.S.C.

37" D. FIR N 02 1/2° E, 33 1/2 FT.
 19" I. CEDAR N 59° E, 34 1/2 FT.
 25" D. FIR S 04 1/2° W, 34 1/2 FT.

MONUMENT ON MODERATE SE SLOPE 175' NORTH OF GRAVEL RD.

CS 67/55-3
 314

Date: 2/1/2001 By: JP

This survey consists of:

Map: M 132-70

Narrative: _____

Corner Rpt: CS 65/36-2C

OREGON CORNER RESTORATION FORM

Section 34 Township 26S Range 2W

County Douglas Date Jan. 24, 2001

DOUGLAS COUNTY SURVEYOR

Corner Designation

1/4
533 | 534

- Condition Report Only
- Not Found
- Renewed
- Unrecorded
- Surveyed In
- Referenced Out

Previous Renewals/Surveys, etc.


Tom Shrum, 1979, M 76-56
U.S.B.L.M., 1979, Wayne Rogers

Monument(s) & Accessories Found: (Condition and Source)

Found 2 1/2" Alum. Cap on a 3/4" Iron Pipe, from which a:
26" D. Fir BT, face overgrown, bears S64°W (Bearing S67°W),
38 3/4 feet.
20" D. Fir BT, scribes visible, bears S23 1/2°E (also Bearing
S20 1/2°E), 28 1/2 feet.

Monument Detail

Sketch

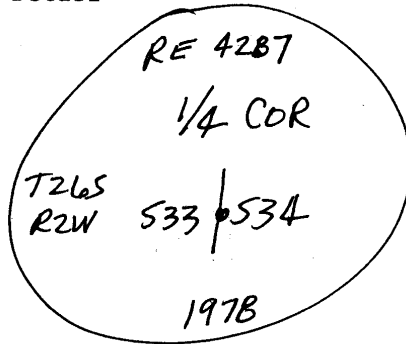

Monument Set (Procedures and Description)

None.

New Accessories

None.

Location & Comments

Corner sits 150 feet
NE of switchback
on rock access road.

Compass Declination 20°E
 Firm/Agency Shaner Engineering
 Address P.O. Box 1430
Roseburg, Oregon 97470
 Party Chief B. Shaner
 Notes " "
 Witness David Snyder
Claude McLean

Surveyor's Seal

REGISTERED
 PROFESSIONAL
 LAND SURVEYOR

Bruce A. Shaner
 OREGON
 OCT. 4, 1957
 BRUCE A. SHANER
 430

Renewed June 30,
2002

CS 67/55-3
4/4

E.S. File No. 65/36-2C