

TOWNSHIP 26S RANGE 3W SEC. 1

PLSS # 640600

Date: 11/14/2022 By: SC

This survey consists of:

Map: _____

Narrative: _____

Corner Rpt: CS67/55-4

DOUGLAS COUNTY OREGON

DATE 11-07-22

DOUGLAS COUNTY SURVEYOR

Corner Designation

$\frac{1}{4}$ COR $\frac{S1}{S12}$

Monument(s) Found: (Condition and Source)

2 1/2" BRASS CAP ON 1" I.D
Iron Pipe DOWN 8"

___ Condition report

___ Not Found

___ Renewed

___ Unrecorded

___ Surveyed In

Previous Renewals

IRVING 1928 CS 14/28 & old
Cor Book Pg 187

Buyer 1937 CS 30/21A old
Rev. Book Pg 187

DCSO 1957 CS 49/48-1
BLM Resurvey 1962-1963

Vol 32 Pg 13375

MONUMENT DETAIL

Douglas County Surveyors

T26S

$\frac{1}{4}$ $\frac{S1}{S12}$

R3W

1977

Accessories Found

DCSO 1972 CS 54/7-69

DCSO 1977 CS 59/40-49

DCSO 1984 CS 62/21-13

DCSO 2008 CS 67/25-28

AULAND ODOT 2011 ST. Hwy 138-D13A-C

ACCESSORIES FOUND

1957 DCSO BT

Singed - SAWN 31" X 3 FT D. EXT STUMP 538 1/2 E

122.7 FT (Rec 123.1 FT) ADD 3 1/2" MAG NAIL TOP

Center, POSSIBLE LOWER BLAZE

60" X 2 FT CEDAR STUMP BURNT N 46° E 81.0 FT

(Rec 80.5 FT) 3 1/2" MAG NAIL TOP CENTER, HEALED

LOWER BLAZE

DCSO 1984 BT

LIVE 20" MAPLE N 6° W 23.5 FT SCRIBE NOT

VISIBLE

C.S. File 67/55-4

New Accessories

GALVANIZED Reflector Post (NO Reflector)
N 30W 9.5 FT

Sketch of Monument, Accessories, and General Area


Location & Comments

CORNER ACROSS HWY FROM
ROCK CREEK GUARD STATION
NEW BURNT

CORNER ON WEST
EDGE OF PAVEMENT
HWY 138.

OCRS COORDINATE SYSTEM
COTTAGE GROVE CANYONVILLE
ZONE NAD 88
N 180 958.843
E 252465.929

AREA BURNT
9-2020
Comp. Decline. 14 1/2° E
Agency DCSO
Party Chief S. F. House
Note keeper
Witnesses J. Lorusso

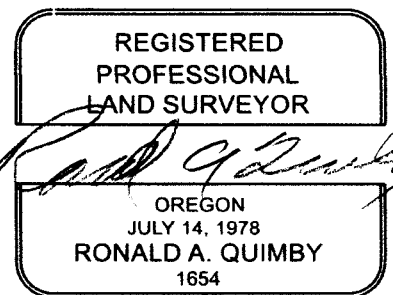

EXPIRES: 12/31/2022

CS 67/55-4

RTK GPS

11/07/22

H.I. 2.000M

TOWNSHIP 26 RANGE 03 POINT IDENTIFIER # 640600

PRIMARY CORNER DESCRIPTION 1/4 Cor Secs 1 & 12

| | |
|-------------|-------------------|
| Alias _____ | Description _____ |
| Alias _____ | Description _____ |
| Alias _____ | Description _____ |
| Alias _____ | Description _____ |

No trace of Brass cap found, due to addition of rip-rap to hold fill of N. Umpqua Hwy.
 Set Brass cap at cor. mkd. County Surveyor's T26S R3W Office 1972 $\frac{1}{4} \begin{matrix} S 1 \\ S 12 \end{matrix}$

Note: hole could only be dug 1 ft. deep, built rock mound 5 ft. across & 2 ft. high around pipe. Corner lies 14.0 ft. west of west edge of pavement & across road from Rock Creek Guard Station.

Doug. County Surveyors Office - R.B. Kimberling; M.W. Cline October 18, 1977 - C.S. File 59/40-49

Found - 1" x 30" I.P. with brass cap, properly mkd., laying 4 ft. west of corner location.
 12" now 14" R.Fir bears S.38 $\frac{1}{2}$ °E., 123.1 ft. with well healed double blaze.
 36" Cedar bears N.46°E., 80.5 ft. with double blaze scribing " $\frac{1}{4}$ S1 CS BT" in upper blaze.

Set - 1" x 30" I.P. with brass cap set at edge of pavement level mkd: Douglas County Surveyors T 26 S 1977 $\frac{1}{4} \begin{matrix} S 1 \\ S 12 \end{matrix}$
 R 3 W

No new accessories. Cor. is at west edge of pavement across the road from Rock Creek Guard Station. We set a steel fence post with survey marker sign 1.0 ft. west of brass cap.

Doug. County Surveyors Office - Randall W. Smith; Stephen J. Flause - November 26, 1984 - C.S. File 62/21-13

Found - 1977 DCSO brass disk on an I.P. flush with ground. *2 1/2" BC / 1" I.D. / 1" PROPERLY MKD. BURIED 8"*

SINGED
SAWN 31" x 3 FT. STAMP
BURNED SAWN 60" x 2 FT STAMP
LIVE 20"

12" now 21" D.Fir with a well healed double blaze bears S.38 $\frac{1}{2}$ °E., 122.1 ft. *122 I ADD 3/8" MAG NAIL TOP CNTR. POSS. LOWER BLZ.*

36" now 42" Cedar with a partially healed double blaze scribing visible in upper blaze "S BT" *EVID. HEALED LOWER BLZ*
 bears N.46°E., 80.5 ft. *81 FT*

Steel fence post with sign bears S.67 $\frac{1}{2}$ °W, 1.1 ft. *NOW BENT ANK DOWN*

New BT - ~~S~~ Maple, bark scribed " $\frac{1}{4}$ S1 CS BT" which faces *SCRIBING NOT VIS.*
 S.45°E., bears N.6°W, 23.5 ft.

Cor. is at west edge of pavement (Hwy #138) across hwy. from Rock Creek Guard Station. *← BURNED DOWN*

DECLINATION 14 1/2 E

NEW REF
 continued next page
GALVANIZED REFLECTOR POST (NO REFLECTION) N03°W, 95 FT

CS 67/55-4
3/4

TOWNSHIP 26 RANGE 03 POINT IDENTIFIER # 640600

PRIMARY CORNER DESCRIPTION 1/4 Cor Secs 1 & 12

| | |
|-------------|-------------------|
| Alias _____ | Description _____ |
| Alias _____ | Description _____ |
| Alias _____ | Description _____ |
| Alias _____ | Description _____ |

Douglas Co. Surveyors Office - John Pike - Stephen J. Flause
- 2/27/2008 - C.S. File 67/25-28

Found OK, 3 live BTs as per rec. Note: 1977 BC/IP now 4"
below ground approx. 1 ft west edge of AC in pullout area.

FD BC, 1' from edge of pavement on hwy, 0.6' below surface,
good condition - by Andrew Ausland, ODOT 8/2011 ST HWY 138-
013 A-C

CS 67/55-4
4/4 3