

GOVERNMENT CORNER RESTORATION FORM

FILED

TOWNSHIP 24S RANGE 2W SEC. 7

PLSS # 100560 Date: 11/14/2022 By: SC

This survey consists of:

Map: _____

Narrative: _____

Corner Rpt: CS 67/55-5

DOUGLAS COUNTY OREGON

DATE 11-8-22

DOUGLAS COUNTY
SURVEYOR

Corner Designation

N $\frac{1}{16}$ S12 | S7
T26S 3W | T26S 2W

Monument(s) Found: (Condition and Source)

2 1/2" BRASS CAP ON 1" IRON
PIPE FLUSH WITH GROUND
IN ROUGH STONE MOUND

Previous Renewals

Set by DCSD 1978
M 65-73 - CS 60/7

___ Condition report

___ Not Found

Renewed

___ Unrecorded

___ Surveyed In

MONUMENT DETAIL

Douglas CO
SURVEYOR

T26S

N $\frac{1}{16}$

S12 | S7

R3W | R2W

1978

Accessories Found

BURNED - SAWN 30" X 2 FT R. CEDAR STUMP
N 51° W 28.5 FT LOWER BLAZE GOOD SCAR
3 1/2" MAG NAIL TOP CENTER

BURNED SAWN 31" X 2 FT D. FIR STUMP
S 84° W 27.1 FT (REC 26.8 FT) 3 1/2" MAG NAIL
TOP CENTER, HEALED LOWER BLAZE

C.S. File 67/55-5

New Accessories

BURNED - DEAD 14" Hemlock 55°E
22.3 FT 3 1/2" MAG Nail RIGHT side Center

Sketch of Monument, Accessories, and General Area

Location & Comments


MON ON MODERATE SOUTH
SLOPE JUST SOUTH OF
BROAD BENCH AND 155'±
NORTH OF POWER LINE ACCESS
ROAD

AREA BURNED
9-2020

OCES COORDINATE SYSTEM
COTTAGE GROVE - CANYONVILLE
ZONE NAD 88

Comp. Decline. 14 1/2° E
Agency DCSO
Party Chief S. FIAUSE
Note keeper
Witnesses J. LORSUNG

N 179564.416
E 255082.801

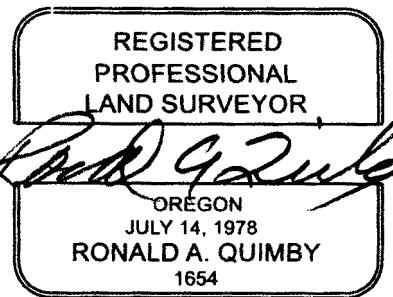

EXPIRES: 12/31/2022

43 CS67/55-5

ATK GPS

RENEWED 11/08/22

TOWNSHIP 26 RANGE 02 POINT IDENTIFIER # 100560

PRIMARY CORNER DESCRIPTION N 1/16 Cor S 7; & S 12 of T26-3

Alias _____	Description _____
Alias _____	Description _____
Alias _____	Description _____
Alias _____	Description _____

Doug. County Surveyors Office - Gary Langlitz; Larry Monrean; S.J. Flause; F.C. Silagy - March 1978 - C.S. 60/7; M 65-73

Set - Corner location determined by survey. At the corner point SET a 1" x 30" I.P. 28" in the ground, with brass cap attached marked:

Douglas Co. Surveyor 1978

✓ T 26 S 2 1/2" BE PROPERLY MKRD
 ✓ N 1/16 FLUSH WITH GROUND
 S 12 | S 7 IN ROUGH STONE MOUND
 R 3 W R 2 W

BURNED SAWN 30" x 2 FT STUMP 12"

BURNED SAWN 31" x 2 FT STUMP 15"

R. Cedar scribed "N 1/16 S12 CS BT" on a double
 blaze, bears N. 51° W, 28.5 ft. LOWER BLZ SCAR
 D. Fir scribed "N 1/16 S12 CS BT" on a double
 blaze bears S. 34° W, 26.8 ft. 27" EVIDENCE

Corner located approx. 50 ft. south of Road #26-2-7.1

THIS RD NOW GONE

FH LOWER BLZ.

NEW REF.

BURNED DEAD 1/4" HEMLOCK 3 1/2" MAGNOL RSG S 51° E, 22.3

MON ON MODERATE SOUTH SLOPE JUST SOUTH OF BROAD BENCH AND IS ~ 155 FT. NORTH FROM POWERLINE ACCESS RD.

CS 67/55-5