

TOWNSHIP 26S RANGE 2W SEC. TRACT 38 PLSS # 597144 Date: 11/14/2022 By: X

This survey consists of:

DOUGLAS COUNTY OREGON

DATE 11-10-21

Map: \_\_\_\_\_

Narrative: \_\_\_\_\_

Corner Rpt: 67/55-6

DOUGLAS COUNTY SURVEYOR

Corner Designation

S.E COR TRACT 38  
COR # 4

Monument(s) Found: (Condition and Source)

2 1/2" GLO BRASS CAP ON  
1" I.D IRON PIPE SET  
FLUSH WITH GROUND

Previous Renewals

GLO RESURVEY 1916 - 1918  
Vol 10 pg 4343  
DCSO 1967 CS 54/40-31  
BLM RESURVEY 1992 - 1995  
Vol 51 pg 19757

- Condition report
- Not Found
- Renewed
- Unrecorded
- Surveyed In

MONUMENT DETAIL

T 38 | T 26S  
4 | R 2W  
535  
1918

Accessories Found

GLO BEARING TREE  
SHATTERED TO GROUND CEDAR STUMP N 80°W  
20.5 FT  
DCSO BT'S  
BURNT-DOWN CEDAR N 26°W 52.1 FT  
BLM BT'S  
LIVE 16" W. FIRE S 60°W 13.2 FT FULLY HEALED  
SINGLE BLAZE (Rec S. 10°W)

C.S. File 67/55-6

\_\_\_\_\_  
\_\_\_\_\_  
New Accessories

Burnt - SAWN 18" X 3' Cedar stump N120°W  
25.8 FT 3 1/2" MAG NAIL Top Center

Burnt - SAWN 18" X 1' Fir stump N70°E  
53.6 FT 3 1/2" MAG NAIL Top Center

50" D. FIR WITH LINE CROSSING TAG  
555°E 57 FT

Sketch of Monument, Accessories, and General Area

Location & Comments

Lat. 43°15'52.18" N  
Long. 122°54'06.72" W

Monument is on  
Flat bench 25  
FT. West of  
GRAVEL ROAD

AREA Burnt

9/2020


Comp. Decline. 14 1/2°E

Agency DCSO


Party Chief S. Fause

Note keeper

Witnesses J. Loisinger

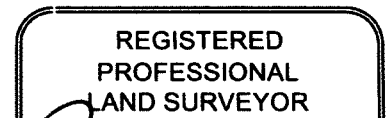

*Paul A. Quimby*

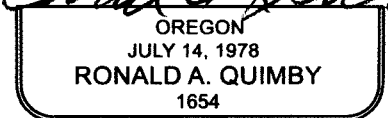

EXPIRES: 12/31/2022

2/4 CS67/55-6

TOWNSHIP 26 RANGE 02 POINT IDENTIFIER # 547144

PRIMARY CORNER DESCRIPTION (SE) Corner No. 4 Tract 38

Alias \_\_\_\_\_ Description \_\_\_\_\_  
 Alias \_\_\_\_\_ Description \_\_\_\_\_  
 Alias \_\_\_\_\_ Description \_\_\_\_\_  
 Alias \_\_\_\_\_ Description \_\_\_\_\_

GLO resurvey by Fred Mensch, U.S. Cadastral Engineer; under Instructions dated May 25, 1916 & April 16, 1918, - (DCSO records Vol. 10 Page(s) 4343)

-----

Set an iron post, 3 ft. long, 1" dia., 26" in the ground, for cor. No. 4 of Tract 38, with brass cap mark

TR38	T26S
4	R2W

S35  
1918

from which  
A cedar, 14" dia., bears N.8°W., 31 lks., mkd: 4 TR 38 BT.

Douglas Co. Surveyors Office - Vernon "Ray" Tracy - Jack Heritage - D. West - July 1967 - C.S. File 54/40-31

-----

Found - 1918 GLO brass cap, firmly set.  
14", now 16" cedar, alive, N.8°W., 20.5 ft., prev. opened & scribe visible "4 TR 38 BT" on decaying blaze.

New BTs- 14" cedar N.26°W., 52.3 ft. mkd. "4 TR 38 CS BT"  
10" W.Fir S.16°E., 29.1 ft. mkd. "4 TR 38 CS BT"

Note - This corner lies on very gentle, southeast slope.

BLM dependent resurvey by Dale T. Bedell & Bryan S. Seibold, Cadastral Surveyors & Robert H. Browning, Survey Technician, under Group No. 1638, surveyed July 1992/April 1995 - (DCSO records Vol. 51 (Page(s) 19757)

-----

Corner No. 4 of Tract 38, perpetuated by Tracy, in 1967; monumented with an iron post, 1" dia., firmly set, projecting ~~3 ins. above the ground~~, with brass cap mkd. **2 1/2" GLO BC / 1" I.D.I.P. FLUSH WITH GROUND**

TR 38	T26S
4	R2W

S 35  
1918

DECLINATION 14 1/2° E

from which the original bearing tree **20 5**  
 A cedar, ~~17"~~ dia., bears N.8°W., 31 lks., with scribe marks ~~TR 38~~ visible on a partially healed blaze.

**SHATTERED TO GROUND STUMP**  
 and bearing tree mkd. by Tracy

**BURNED DOWN** A cedar, ~~19"~~ dia., bears N.26°W., 79 lks., with scribe marks ~~TR38 CS BT~~ visible on a partially healed blaze.

and a new bearing tree **06° 13 1/2**  
 LIVE 16" A fir, ~~9"~~ dia., bears S. ~~18°~~ W., 20 lks., mkd. ~~S35 BT.~~ **FHSB**

continued next page

**NEW REFS BURNED SAWN 18" x 3 FT CEDAR STUMP N20°W, 25 1/2 FT 3 1/2" MAG NAIL TOP CNTR.**

**" " 18" x 1 FT. FIR STUMP N70°E, 53 1/2 FT. 3 1/2" MAG NAIL TOP CNTR.**

**50+ INCH D. FIR / LINE CROSSING TAG ≈ S55°E, 57 FT.**

**BC MON. ON FLAT BENCH ≈ 25 FT WEST OF GRAVEL RD. CS 6/55-6 3/4**

TOWNSHIP 26 RANGE 02 POINT IDENTIFIER # 547144

PRIMARY CORNER DESCRIPTION (SE) Corner No. 4 Tract 38

Alias \_\_\_\_\_ Description \_\_\_\_\_  
Alias \_\_\_\_\_ Description \_\_\_\_\_  
Alias \_\_\_\_\_ Description \_\_\_\_\_  
Alias \_\_\_\_\_ Description \_\_\_\_\_

The corner is located on a gentle S. slope 50 lks. W. of a  
graveled road 30 lks. wide, bears N. 20° E. and S. 20° W.

(NAD 1927 - from map)	Latitude	43°15'52.69"N
(NAD 1927 - from map)	Longitude	122°54'02.46"W

From this corner, National Geological Survey triangulation  
station "SHIVIGNY", 1953, bears N.66°23'30"W., 81.860 chs.  
(mean bearing and sea level dist.); monumented with a brass  
disk, 3" dia., set in a concrete post, 10" square, projecting  
4" above the ground, mkd. NATIONAL GEOLOGICAL SURVEY SHIVIGNY  
1953 1977 and a triangle.

CS 62/55-4  
4/4 2