

GOVERNMENT CORNER RESTORATION FORM

FILED

TOWNSHIP 26S RANGE 1W SEC. 8

PLSS # 240540

Date: 11/16/2022 By: XC

This survey consists of:

Map: _____

DOUGLAS COUNTY OREGON

DATE 11-9-22

Narrative: _____

Corner Rpt: CS 67/55-7

Corner Designation

C 1/4 SE

DOUGLAS COUNTY
SURVEYOR

Monument(s) Found: (Condition and Source)

___ Condition report

3" BRASS CAP ON 2" ID
IRON PIPE 4" 8"

___ Not Found

Renewed

___ Unrecorded

Previous Renewals

___ Surveyed In

Grubb 1981 M 87-37

MONUMENT DETAIL

T26S R1W

C 1/4 SE

1981

PLS 397

Accessories Found

BURNED DEAD 15" Hemlock S75°E 22.0 FT
(Rec S73°E 22.2 FT) Fully Healed Double
BLAZE ADD 3 1/2" MAG NAIL RIGHT SIDE
CENTER

BURNED - DEAD 14" Hemlock S19°W 20.6 FT.
(Rec S17°W 20.5 FT) Fully Healed Double
BLAZE 3 1/2" MAG NAIL RIGHT SIDE CENTER

C.S. File 67/55-7

Monument Set (Procedure and Description)

MONUMENT DETAIL

New Accessories

BURNED DEAD 40" D. FIR N47°E 18.6 FT
3 1/2" MAG NAIL RIGHT SIDE CENTER NOT
BLAZED OR SCRIBED

BURNED DEAD 54" D. FIR S25°E 29.0 FT
3 1/2" MAG NAIL RIGHT SIDE CENTER
NOT BLAZED OR SCRIBED


Sketch of Monument, Accessories, and General Area

Location & Comments

LAT. 43°19'15.49" N
LONG 122°50'40.01" W

AREA BURNT
9-2020

Comp. Decline. 14 1/2° E
Agency DCSO
Party Chief S. FIAUSE
Note keeper
Witnesses J. LOISUNG

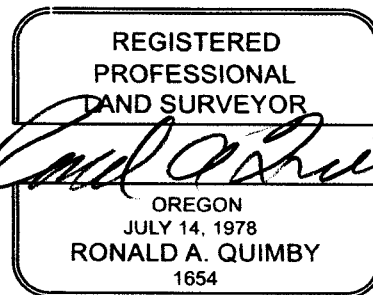

CS 67/55-7

MM GPS 11/8/22
TIME - 13.05
H.I. - 2,000M

RENEWED 11/09/22

TOWNSHIP 26 RANGE 01 POINT IDENTIFIER # 240540

PRIMARY CORNER DESCRIPTION Center 1/4 Cor. Sec. 8

Alias	Description
Alias	Description
Alias	Description
Alias	Description

575°E

George Grubb - For: US Forest Service - April 1981 M87-37

Set - 2"x30" iron pipe 24" in the ground with a 3" brass cap
mkd: T26S R1W C 88 1981 P2S 397

BURNED DEAD 15" 9"
" 14" 7"

Hemlock bears S 28° E., 22.2 ft. scribed "C 4 S8 BT"
hemlock bears S 14° W., 20.8 ft. scribed "C 4 S8 BT"

MKD AS DESCRIBED.
12" D.I.P.
PROT 8"
F.A.D.B.
ADD 3 1/2" MAGNAIL R.S.C.
TO BOTH F.N.P. B.T.S.

NEW REFS

DEAD BURNED 40" D. FIR 3 1/2" MAGNAIL R.S.C. N 47° E, 186
" " 54 D. FIR " S 25° E, 290

CS 67/55-7
3/3