

GOVERNMENT CORNER RESTORATION FORM

FILED

TOWNSHIP 26S RANGE 3W SEC. 1

PLSS # 620600 Date: 11/16/2022 By: XC

This survey consists of:

DOUGLAS COUNTY OREGON

DATE 11-9-22

Map: _____

Narrative: _____

Corner Rpt: 67/55-8

DOUGLAS COUNTY SURVEYOR

Corner Designation

W 1/16 S1
512

Monument(s) Found: (Condition and Source)

2 1/2" BRASS CAP ON 1"
IRON PIPE SET FLUSH

___ Condition report

___ Not Found

Renewed

___ Unrecorded

___ Surveyed In

Previous Renewals

DCSD 1978 M 65-73

MONUMENT DETAIL

Douglas County
Surveyor
T26S R3W
W 1/16 S1
512
1978

Accessories Found

BURNED AWAY HOLE 14" YAW S170W 15.1 FT

45" D. Fir N54W 99.0 (Rec N53W 99 FT)

Fully Healed Double BLAZE

ADD 3 1/2" MAG NAIL RIGHT SIDE CENTER

GALVANIZED steel Post West 0.5 FT

C.S. File 67/55-8

New Accessories

Unrecorded Lone Rock Timber BT
40" D. FIR BARK BLAZED NO SCRIBE
N 12° E 50.3 FT ADD 3 1/2" MAG NAIL
RIGHT SIDE CENTER


Sketch of Monument, Accessories, and General Area

Location & Comments

CORNER LIES APPROX. 540° E
40 FT FROM INTERSECT OF
Four wheel drive ROAD
Intersection RUNNING EAST
West & North 4 wheel drive
ROAD NOW TANK TRAPPED
O CRS COORD. SYSTEM
NAD 1988
N 181027.633
E 251141.311

AREA BURNED
9-2020

Comp. Decline. 14 1/2° E
Agency DCSO
Party Chief S. FIAUSE
Note keeper
Witnesses J. LORSUNG

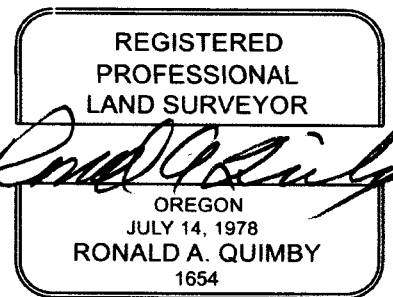

EXPIRES: 12/31/2022

CS 67/55-8 213

MMGPS ATK 11/9/22

RENEWED 11/9/22

TIME-9:05
H.I.-2.000M

TOWNSHIP 26 RANGE 03 POINT IDENTIFIER # 620600

PRIMARY CORNER DESCRIPTION West 1/16 Cor for Secs 1 & 12

Alias _____	Description _____
Alias _____	Description _____
Alias _____	Description _____
Alias _____	Description _____

Doug. County Surveyors Office - Gary Langlitz; L.E. Monrean
Frank Silagy; Stephen Flause - March 2, 1978 - M 65-73;
C.S. File 60/7

Set - 1" x 30" Glav. I.P. with brass cap 3" above ground
at W 1/16 corner as proportioned in survey. Cap
stamped: Douglas County Survey T 26S R 3 W
1978 W 1/16 S 1
S 12

~~BTs~~ ^{BURNED AWAY} 14" bears S.17°W., 15.1 ft. Tree double blazed
and scribed "W 1/16 S12 CS BT". ^{HOLE} ✓

~~45" 35"~~ D. Fir bears N.53°W., 99.8 ft. Tree double blazed
and scribed "W 1/16 S1 CS BT". ^{N 54°W, 99'} ←

Corner lies approx. S.40°E., 40 ft. of intersect of four-wheel
drive road, intersection running East, West, and North.

4WD ROAD NOW TANK TRAPPED

2 1/2" BC
MARKED
AS DESCRBD.
FLUSH
WITH GRND.
FHDB
ADD 3 1/2"
MAG NAIL
R.S.C.

NEW REFS

UNRECORDED

LONE ROCK BT BURNED DEAD 40' D. FIR BARK 3/2 NO SCRB, N12°E, 50.3

ADD 3 1/2" MAG
NAIL R.S.C.

SALVANIZED STEEL LATH FOUND 0.5 FT, WEST

DECLINATION 14 1/2° E

CS 67/55-8
3/3