

TOWNSHIP 265 RANGE 3W SEC. 326 PLSS # 500260

Date: 11-23-2022 By: JC
This survey consists of:

DOUGLAS COUNTY OREGON

DATE 1-19-22

Map: _____

Narrative: _____

Corner Rpt: CS67/55-9

Corner Designation

N 1/16 527/526

DOUGLAS COUNTY
SURVEYOR

Monument(s) Found: (Condition and Source)

2 1/2" Alum CAP ON 5/8"

Iron ROD UP 1"

___ Condition report

___ Not Found

Renewed

___ Unrecorded

___ Surveyed In

Previous Renewals

No fine 1995 M 122-80

BLM Resurvey 2008 Vol 59

Pg 22703

MONUMENT DETAIL

Lone Rock Timber

N 1/16

527/526

1995

PLS 2291

Accessories Found

BURNED SAWN 22" X 4 1/2' D.F STUMP N 6 1/2° E
20.9 FT (REC 20.4 FT) HEALED BLAZE ADD

3 1/2" MAG NAIL RIGHT SIDE CENTER

BURNED - SAWN 21" X 2 1/2" D. FIR STUMP

S 19° E 29.3 FT (REC S 17 1/2° E 28.9 FT) BLAZE - SCAR

3 1/2" MAG NAIL TOP CENTER

FD UNRECORDED BY

17" D. FIR N 39 1/2° W 45.5 FT HEALED SINGLE

BLAZE BY TAG READS S 38° E 45.4 FT ADD

3 1/2" MAG NAIL RIGHT SIDE CENTER

Alum. Post 1.5 FT North

C.S. File 67/55-9

RENEWAL

Monument Set (Procedure and Description)

MONUMENT DETAIL

New Accessories

Sketch of Monument, Accessories, and General Area


Location & Comments

CORNER IS 52 FT N. OF GRAVEL
ROAD 12' WIDE BEARS N 59° W
& S 54° E

LAT. 43° 16' 56.64" N
LONG 123° 01' 47.86" W

AREA BURNED
9/2020

Comp. Decline. 14 1/2° E
Agency DCSD
Party Chief S. FRAUSE
Note keeper
Witnesses J. LORSUNG

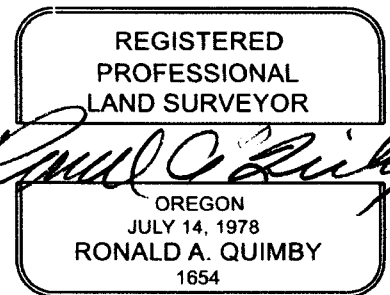

EXPIRES: 12/31/2022

CS 67/55-9

W/59

22703

Dependent Resurvey of a Portion of the Subdivisional Lines,
T. 26 S., R. 3 W., Willamette Meridian, Oregon

The N 1/16 sec. cor. of secs. 26 and 27, established by Kenneth W. Hoffine, Oregon PLS No. 2291, in 1995, filed in the Douglas County Surveyor's Office, Map File No. M122-80, and is accepted as the cor., monumented with an iron rebar $\sqrt{5/8}$ in. diam., firmly set, projecting 3 ins. above the ground, with aluminum cap mkd.

LONE ROCK TIMBER
N 1/16
S 27 | S 26
1995
PLS 2291

2 1/2" ALUMINUM CAP
MON. PROT. 1"

from which bearing trees mkd. by Hoffine

BURNED SAWN STUMP AD,
22" x 6 1/2 FT. TALL

✓ 209
fir, 21 ins. diam., bears N. 6 1/2° E., 20.4 ft. dist., with a healed blaze.

FHSB
ADD 3 1/2" MAG NAIL R.S.C.

BURNED SAWN STUMP AD,
21" x 2 1/2 FT. TALL

✓ 293
fir, 19 ins. diam., bears S. 19° E., 28.9 ft. dist., with a healed blaze.

BLZ. SCAR
ADD 3 1/2" MAG NAIL
TOP CNTR.

Corner is located 52 ft. N. of a graveled road, 12 ft. wide, bears N. 54° W. and S. 54° E.

FOUND UNRECORDED BT.

ALIVE 17" D. FIR WITH A FULLY HEALED SINGLE BLAZE;

BEARS N 39 1/2° W, 45 5 FT. (BT TAG READS S 38° E, 45 4 FT.)

ADD 3 1/2" MAG NAIL R.S.C.

AN ALUMINUM LATH 1"x1" IS FOUND 15' NORTH.

CS 67/55-9

3/3