

GOVERNMENT CORNER RESTORATION FORM

FILED

TOWNSHIP 243 RANGE 2W SEC. 29 PLSS # 240206

Date: 11/23/2022 By: SC  
This survey consists of:

DOUGLAS COUNTY OREGON

DATE 10-25-22

Map: \_\_\_\_\_

Narrative: \_\_\_\_\_

Corner Rpt: CS67/55-11

Corner Designation

1/4 COR 29  
32

DOUGLAS COUNTY  
SURVEYOR

Monument(s) Found: (Condition and Source)

2 1/2" BRASS CAP ON 1" IRON  
PIPE UP 4"

\_\_\_ Condition report

\_\_\_ Not Found

Renewed

\_\_\_ Unrecorded

\_\_\_ Surveyed In

Previous Renewals

BLM RESURVEY 1951-1963 Vol  
32 pg 13303

DCSO 1969 CS 54/27-254

RICE 2012 CS 65/77-35

MONUMENT DETAIL

1/4 529  
4 532  
1951

Accessories Found

ORIG B.T

BURIED STUMP 30" X 7' FIR S 4 1/2° E 22.5 FT  
(REC S 11° E 23.1 FT) 3 1/2" MAG NAIL RIGHT SIDE  
CENTER

BLM B.T

BURNT 50" X 5' FIR STUMP S 36 1/2° E 23.7 FT  
(REC S 42° 45' E 24.4 FT) FACE GONE 3 1/2"  
MAG NAIL TOP CENTER

3/4" I.R. S 87° W 5.1 FT (REC WEST 5.0 FT)

RICE B.T

BURNT-SAWN 25" X 8' D. FIR STUMP N 42° E  
3.7 FT 3 1/2" MAG NAIL RIGHT SIDE CENTER

1 1/4" I.D. IRON PIPE NOT OF RECORD

NORTH 2.15 FT (PROTRUDES 2")

STEEL POST ADJACENT TO B.C.

C.S. File 67/55-11

Horizontal lines for monument set procedure and description.

New Accessories

Horizontal lines for new accessories.

Sketch of Monument, Accessories, and General Area

Location & Comments


CORNER ON moderate North Slope Just South From Ridge Saddle

CORNER IS S30°E 90'± From END OF Gravel Spur ROAD

Lat 43°26'43.64"N  
Long 122°57'35.55"W

AREA BURNED 9-2020

Comp. Decline 14 1/2°E  
Agency DCSD  
Party Chief S. FIAUSE  
Note keeper  
Witnesses J LORSUNG

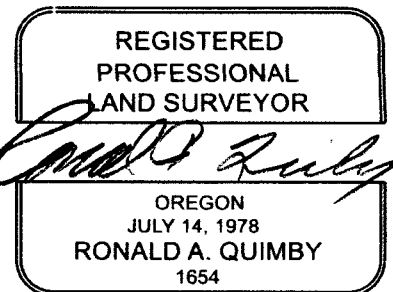

EXPIRES: 12/31/2022

MM GPS 10/25/22  
TIME - 12:05  
HI - 2,000M

RENEWED 10/25/22

TOWNSHIP 24 RANGE 02 POINT IDENTIFIER # 240200

PRIMARY CORNER DESCRIPTION 1/4 Cor. Secs. 29 & 32

Alias	Description
_____	_____
_____	_____
_____	_____
_____	_____

Ron Rice, NW Land Surveying/- Jason Collver - Sept. 6, 2012 -  
C.S. File 65/77-35

*2 1/2" PROXIMALY MKD. PROT. 4"*

Found - 1" dia. Iron post with BLM brass cap dated 1951

*BURNED STUMP 30" X 7 FT BARK GONE* - Orig. 40" Fir (snag) ~~S. 11° E., 23.1 ft., bark scribe~~ *S 04' 12" E, 22.5'*  
*NOW BURNED 50" X 5 FT TALL 50" FIR STUMP* ~~S. 42° 45' E. 24.4 ft scribe visible (Fd)~~ *S 36' 12" E, 23.3'*  
*GONE IN DIR TRD. EXCAV* ~~3/4" I.R. North 20.0 ft. (Fd)~~ *FACE GONE*

*BURNED SAWN 25" X 8 FT STAMP* ~~3/4" I.R. West 5.0 ft., from 1/4 cor. (Fd)~~ *S 87° W 5' FT*  
 2" D. Fir bears N. 42° E. 3.7 ft., scribed 1/4 S29 BT

Note - Corner has steel post adjacent to it. All BTs have orange painted bands and yellow tags.

Decl. 16° East

*DECLINATION 14' 12" E*

*FND NOT OF RECORD - 1 1/4" I.D. IRON PIPE PROT. 2"*  
*BEARS NORTH, 2 1/5 FT. DIST*

*MON. ON MODERATE NORTH SLOPE JUST SOUTH FROM RIDGE SADDLE*  
*AND S 30° E ≈ 90 FT. FROM END OF GRAVELLED SPUR RR.*

*CS 62/55-11*  
*3/3*