

GOVERNMENT CORNER RESTORATION FORM

FILED

TOWNSHIP 245 RANGE 2W SEC. 32 PLSS # 300140

Date: 11/23/2022 By: X
This survey consists of:

DOUGLAS COUNTY OREGON

DATE 10-26-22

Map: _____

Narrative: _____

Corner Rpt: CS 67/55-12

Corner Designation

1/4 COR S32/S33

DOUGLAS COUNTY
SURVEYOR

Monument(s) Found: (Condition and Source)

2 1/2" BLM BRASS CAP ON
1" Iron pipe Reset Now
Up 3"

___ Condition report

___ Not Found

Renewed

___ Unrecorded

___ Surveyed In

Previous Renewals

BLM Resurvey 1951-1963
Vol 32 pgs 13298-9
Rice 2012 CS 65/77-33

MONUMENT DETAIL

1/4
S32/S33
1951

Accessories Found

BLM BT
Burnt out 10" x 7' yew SNA9 N56'14" W 17.8 FT
FACE GONE

Rice BTs
Burnt-DEAD 19" D. FIR N76°W 10.3 FT Healed
Single BLAZE ADD 3 1/2" MAG NAIL RIGHT
Side Center

Burnt-DEAD 16" Hemlock N68°E 4.4' Healed
Single BLAZE ADD 3 1/2" MAG NAIL RIGHT
Side Center

Burnt-DEAD 22" D. FIR S23°E (REC S20°E)
22.9 FT Healed Single BLAZE ADD 3 1/2"
MAG NAIL RIGHT Side Center

C.S. File 67/55-12

RENEWAL

Monument Set (Procedure and Description)

MONUMENT DETAIL

New Accessories

SAWN - BURNED 12" X 2" FIR STUMP S26 1/2° E
84.3 FT 3 1/2" MAG NAIL TOP CENTER

8" X 6 FT steel Gate Swing Post (most
Northerly Post) S 93 1/4° E 122.5 FT

Sketch of Monument, Accessories, and General Area


Location & Comments

Monument is on moderate
NNE slope approx 130' North
of Gravel Road

LAT 43° 26' 17.82" N
LONG 122° 57' 02.55" W

AREA BURNED
9-2020

Comp. Decline 14 1/2° E
Agency DCSO
Party Chief S. F. HAUSE
Note keeper
Witnesses J. LA SUNG

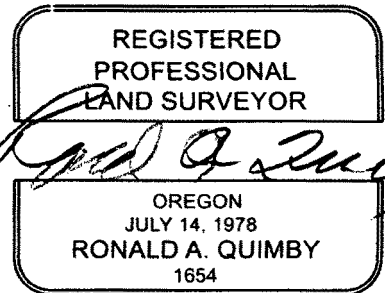

EXPIRES: 12/31/2022

CS 67/55-12

MM GPS 10/26/22
TIME - 10:45
H.I. - 2.000M

RENEWED 10/26/22

TOWNSHIP 24 RANGE 02 POINT IDENTIFIER # 300140

PRIMARY CORNER DESCRIPTION 1/4 Cor Secs 32 & 33

Alias _____	Description _____
Alias _____	Description _____
Alias _____	Description _____
Alias _____	Description _____

GLO survey by John. A. McQuinn, Deputy Surveyor, under Contract #466 dated April 1883 - (DCSO records Vol. 7 Page(s) 2886

Set post, 3 ft. long, & 3" sq., 24" in the ground for the 1/4 sec. cor. marked 1/4 S on W face, from which:
 A hemlock, 18" dia., bears N.20°W., 18 lks., mkd: 1/4 S BT.
 A hemlock, 30" dia., bears S.27°E., 35 lks., mkd: 1/4 S BT.

BLM dependent resurvey Levi E Tallett, Cadastral Engineer (1951) and C. Albert White, Cadastral Surveyor (1963), under Group # 294, surveyed May 1951 - Aug 1963 - (DCSO records Vol. 32 Page(s) 13298-9)

Point for the 1/4 sec. cor. of secs. 32 & 33, at proportionate distance; there is no remaining evidence of the orig. corner. Set an iron post, 36 long, 1" dia., 28" in the ground with brass cap marked:
 S 32 | S 33
 1951

from which
 A Cedar, 13" dia., bears S.82 1/4°E., 43 lks., mkd: 1/4 S33 BT. (1963 BT)
 A yew, 14" dia., bears N.56 1/4°W., 27 lks., mkd: 1/4 S32 BT. (1951 BT, 16" dia., in 1963)

Ron Rice, NW Land Surveying - Jason Collver - Sept. 6, 2012 - C.S. File 65/77-33

Found - 1" dia. Iron post with BLM brass cap dated 1951

~~A Cedar, 13" dia., bears S.82 1/4°E., 28.4 ft., mkd: 1/4 S33 BT. (Fd 13" dia. x 5' high Cedar stump with scribing visible)~~

~~A yew 16" dia., bears N.56 1/4°W., 17.8 ft., mkd: 1/4 S32 BT. (Fd 17" Yew with scribing visible)~~

16" D. Fir bears N.76°W., 10.3 ft., scribed 1/4 S32 BT

14" Hemlock bears N.68°E., 4.6 ft., scribed 1/4 S33 BT

19" D. Fir bears S.22°E., 22.9 ft., scribed 1/4 S33 BT

Note - Corner has steel post adjacent to it. All BTs have red painted bands and yellow tags.
 Dec. 16°E

2 1/2" R. PROPERLY MARKED. PROT. 12 FT ABOVE GROUND. REFERENCE OUT POS. REMOVE AND RESET DEEPER NOW PROT. 8"

GONE BURNED AWAY NO EVID.

BURNED OUT 10" x 7 FT SAGA

BURNED DEAD 19"

BURNED DEAD 16"

BURNED DEAD 22"

FACE GONE

PHSB BURNED FACE

FHSB

ADD 3 1/2" MAG NAIL RSC TO FND, BTs

DECLINATION 14 1/2°E

S23°E

CS67/55-12
3/3

NEW REFERENCES

8" DIA. 6 FT TALL STEEL GATE SWING POST (MOST NRTHLY POST) S093/4°E, 122 1/2

SAWN BURNED 16" x 2 FT FIR STUMP WITH 3 1/2" MAG NAIL TOP FOR S26 1/2°E, 84 3/4 FT.

MON. IS ON MODERATE NNE SLOPE ~ 130 FT. NORTH FROM GRAVEL RD.