

GOVERNMENT CORNER RESTORATION FORM

FILED

TOWNSHIP 24S RANGE 3W SEC. 25 PLSS # 64D260

Date: 12/19/2022 By: JC

This survey consists of:

DOUGLAS COUNTY OREGON

DATE 12-6-22

Map: \_\_\_\_\_

Narrative: \_\_\_\_\_

Corner Rpt: 66/55-16

DOUGLAS COUNTY  
SURVEYOR

Corner Designation

1/4 COR 25  
36

Monument(s) Found: (Condition and Source)

BRASS CAP ON 2" IRON  
PIPE UP 6" CAP MARKING  
ORIENTATED SOUTH

Previous Renewals

HA'le for Weyerhaeuser Co.  
CS 42/323 ADD CS 53/111-25  
BAKER 1995 CS 65/1-4

- Condition report
- Not Found
- Renewed
- Unrecorded
- Surveyed In

MONUMENT DETAIL

T 24S R 3W

1/4 525  
36

PLS 1978

1995

Accessories Found

SAWN BURNT 23" X 6 1/2" FIR STUMP N 37° W  
4.9 FT TO W NAIL  
BURNT 11" FIR S 46° W 6.3 FT TO W NAIL  
BURNT 19" FIR S 71° E 12.2 FT TO W NAIL  
BURNT SAWN 20" X 4" FT FIR STUMP N 37° E  
25.5 FT TO W NAIL

MetAl Fence post 1.5 FT Easterly

C.S. File 67/55-16

RENEWAL

Monument Set (Procedure and Description)

MONUMENT DETAIL

\_\_\_\_\_  
\_\_\_\_\_  
New Accessories

\_\_\_\_\_  
\_\_\_\_\_  

Sketch of Monument, Accessories, and General Area

Location & Comments

LAT 43°26'45.36" N  
LONG 123°00'02.43" W

AREA BURNED  
9-2020

Comp. Decline. 14 1/2° E  
Agency DCSB  
Party Chief S FIKUSE  
Note keeper  
Witnesses J LORSUNG

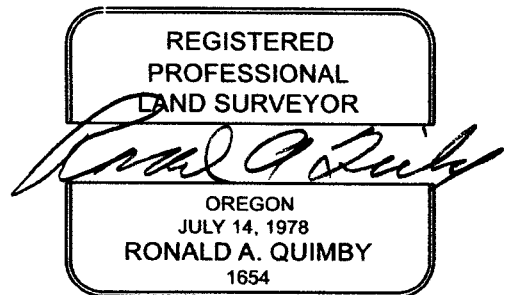

EXPIRES: 12/31/2022

CS 67155 - 16

FOUND OK 12/6/22

TOWNSHIP 24 RANGE 03 POINT IDENTIFIER # 640200

PRIMARY CORNER DESCRIPTION 1/4 Cor. Secs. 25 & 36

Alias _____	Description _____
Alias _____	Description _____
Alias _____	Description _____
Alias _____	Description _____

GLO survey by L.H. Wheeler under Contract No. 467 dated April 7, 1883 (DCSO records Vol. 7 Page(s) 2972-3)

-----

Set yew post 3 ft. long, 3" sq., 24" in the ground for 1/4 sec. cor. marked 1/4 S. on N. face from which

A dogwood, 4" dia., bears N.18°W., 38 lks., mkd: 1/4 S BT.

A fir, 10" dia., bears S.39°W., 76 lks., mkd: 1/4 S BT.

Marion Hale - For: Weyerhaeuser Co. - July 1960 - CS 42/323 (see also C.S. 53/111-25 for 1955 Weyco report)

-----

Found - No evidence of Orig. GLO corner.

Set - 5/8" x 32" monel pipe for corner by the single proportionate method.

Referenced by Weyerhaeuser method. Dec. 20°E

40" Fir stp. S.32°E., 28.7 ft.

41" Fir stp. N.30°E., 42.2 ft.

Daniel Baker, Oct. 18, 1995 - C.S. File 65/1-4

-----

Found - 5/8" Monel pipe

40" Fir stump, S.29°E., 28.7 ft. to "W" nail, rec: S.32°E., 28.7 ft. to "W" nail.

*BURNED AWAY* 43" Fir stump, N.30°E., 42.2 ft. to "W" nail, (same as record)

16" Fir stump, N.32°E., 16.3 ft. to "W" nail, rec: Weyerhaeuser Co. 1956, N.40°E., 13.6 ft. to "W" nail.

Set - Replaced pipe with 2"x32" IP with brass cap marked:

T 24 S R 3 W  
1/4 S 25  
S 36

PLS 1978 1995 *PROT 6"* *CAP STAMPING ORIENTED SOUTH*

16" Fir, N.37°W., 4.9 ft. to "W" nail.

11" Fir, S.46°W., 6.3 ft. to "W" nail.

15" Fir, S.71°E., 12.2 ft. to "W" nail.

15" Fir, N.37°E., 25.5 ft. to "W" nail.

Metal fence post bears 1 ft. West.

*METAL LATH 1 1/2 FT EASTLY*

*ALL BT'S BURNED BUT SOLID COND.*

*SAWN STUMP 2-3" X 5 1/2 FT*

*TREE 11"*

*TREE 19"*

*SAWN STUMP 20" X 7 FT TAIL*

CS 67/55-14

3/3

1