

GOVERNMENT CORNER RESTORATION FORM

FILED

TOWNSHIP 24S RANGE 21W SEC. 29 PLSS # 2002AD

Date: 1-9-2023 By: JC

This survey consists of:

Map: _____

Narrative: _____

Corner Rpt: CS67/55-19

DOUGLAS COUNTY OREGON

DATE 10-27-22

DOUGLAS COUNTY
SURVEYOR

Corner Designation

1/4 COR 30/29

Monument(s) Found: (Condition and Source)

2 1/2" DCSO BRASS CAP

ON 1" I. D. IRON PIPE

UP 13" ADD ROUGH STONE MOUND

Previous Renewals

DCSO 1969 CS 54/27-253

Condition report

Not Found

Renewed

Unrecorded

Surveyed In

MONUMENT DETAIL

COUNTY SURVEYORS
OFFICE
T24S R2W
1/4 S30/29
1969

Accessories Found

Burnt - Broken 46" X 2 FT D. FIR STUMP
N45°W 151.6 FT NO MARKS FOUND

6' steel Post along side

C.S. File 67/55-19

RENEWAL

Monument Set (Procedure and Description)

MONUMENT DETAIL

New Accessories

5/8" X 30" IRON Rod with DCSD yellow Plastic
 Cap S 63° E 13.7 FT up 4"

5/8" X 30" IRON Rod with DCSD yellow Plastic
 Cap N 21° W 15.0 FT up 12"

9" X 8 FT BURNED - SAWN FIR STUMP S 30° W
 14.2 FT 3 1/2" P.K NAIL RIGHT SIDE CENTER

10" X 8 FT BURNED - SAWN FIR STUMP N 85° W
 13.5 FT 3 1/2" P.K NAIL RIGHT SIDE CENTER

Sketch of Monument, Accessories, and General Area

Location & Comments

MON. ON North Edge NEAR
 Top of N.W Running Ridge
 20' south of GRAVEL ROAD

AREA BURNED
 9-2020

OCRS state Plane Coordinate
 System Cottage Grove -
 Canyonville Zone.

Comp. Decline. 14 1/2° E

N 225961.762


Agency DCSD

E. 260634.757

Party Chief S. F. AUSE

Note keeper

Witnesses J. LORSUNG

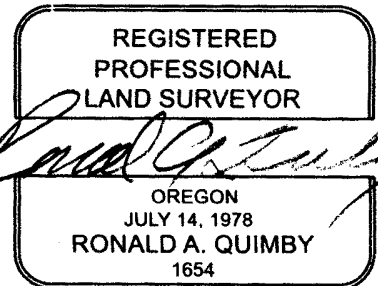

EXPIRES: 12/31/2022

MM GPS 10/27/22
TIME - 9:20
H.I. - 2.000M

RENEW 10/27/22

TOWNSHIP 24 RANGE 02 POINT IDENTIFIER # 200240

PRIMARY CORNER DESCRIPTION 1/4 Cor Secs. 29 & 30

Alias _____	Description _____
Alias _____	Description _____
Alias _____	Description _____
Alias _____	Description _____

GLO survey by John McQuinn, Deputy Surveyor, under Contract #466 dated April 1883 - (DCSO recs. Vol. 7 Page(s) 2881)

Set cedar post, 3 ft. long, & 3" sq., 24" in the ground for the 1/4 sec. cor. marked 1/4 on W face, from which:
A hemlock, 12" dia., bears S.75°E., 52 lks., mkd: 1/4 S BT.
A hemlock, 10" dia., bears N.72°W., 55 lks., mkd: 1/4 S BT.

Douglas Co. Surveyors Office - Vernon "Ray" Tracy - Jack Heritage - V. Perron - Aug 1969 - C.S. File 54/27-253

Found - Orig. 12" now 15" Hemlock stump, S.75°E., 34.3 ft., scribe marks visible.

Hole where NW orig. BT should have been.

Set - Brass cap at cor. mkd: County Surveyors T24S R2W (6' steel fence Office 1969 post alongside) 1/4 S 30 | S 29

New BT - 40" D.Fir N.45°W., 151.6 ft., mkd: "1/4 S30 CS BT" There being no trees in sec. 29, we set: 1/4" I.R. N.70°E., 15.0 ft.

This corner lies on moderate, changing to steep, northerly slope.

BURNED BROKEN 4 1/2" x 2 FT. STUMP
CORNER REMOVED BY ROAD WORK

2 1/2" RC 1" I.D.P. PROT 13"

ADD ROUGH MEASUREMENT OF STONE
NO MARKS FOUND

NEW REFS

- 1) 5/8" x 30" IR / ^{DCSO} YELLOW PROT 6" S63°E, 132 FT. _{PLSTE CAR}
- 2) 9" x 8 FT BURNED SAWN FIR STUMP S30°W, 14 1/2 FT. 3 1/2" SPIKE NAIL RSC
- 3) 10" x 8 FT " " " " N85°W, 13 1/2 FT " " "
- 4) I.R. AS ABOVE (*1) PROT. 12" N 21° W, 15 0 FT.

MON ON NORTH EDGE NEAR TOP OF NW RUNNING RIDGE AND 20 SOUTH FROM GRAVEL RD.