

GOVERNMENT CORNER RESTORATION FORM

FILED

TOWNSHIP 255 RANGE 1W SEC. 35 PLSS # 540100

Date: 1/9/2023 By: SC
This survey consists of:

DOUGLAS COUNTY OREGON

DATE 12-7-22

Map: _____
Narrative: _____
Corner Rpt: CS67/55-20

DOUGLAS COUNTY
SURVEYOR

Corner Designation

SO. 1/4 S 35 ONLY

Monument(s) Found: (Condition and Source)

___ Condition report

BRASS CAP ON 1 1/2" IRON PIPE
DOWN 2 1/2 FT IN TREE TIP OUT
DUG OUT NOW UP 2"

___ Not Found

Renewed

___ Unrecorded

Previous Renewals

___ Surveyed In

GLD SURVEY 1910 Vol 9 pg
3541-72 duplicate pg 4079
GAYLORD 1977 CS 59/40-13
BLM RESURVEY 1997 Vol
53 pgs 20322-3

MONUMENT DETAIL

Accessories Found

- BURNED OUT SPOON FIR STUMP 33" X 4 FT 59° E
22.8 FT 3 1/2" MAG NAIL LEFT SIDE CENTER (REC S 6 1/2° E)
- 44" D. FIR N 32 1/2° E 68.2 FT (REC N 29 1/2° E 69.3 FT)
3 1/2" MAG NAIL RIGHT SIDE CENTER
- 28" D. FIR N 62 1/2° W 26.7 FT (REC N 66 1/4° W)
3 1/2" MAG NAIL LEFT SIDE CENTER (Singed)

C.S. File 67/55-20

New Accessories

5/8" X 30" Iron Rod with DCSD yellow
Plastic Cap up 4" EAST 44.0 FT IN Easterly
Road Shoulder

Sketch of Monument, Accessories, and General Area


Location & Comments

CORNER IS ON moderate EAST
Slope 100 FT[±] EAST OF Ridge
TOP ROAD

CORNER IS 35 FT
WEST OF SPUR ROAD
RUNNING NORTH AND
EAST

Lat: 43° 20' 59.57"
Long: 122° 46' 14.38"

Comp. Decline. 14 1/2° E
Agency DCSD
Party Chief S. CLAUSE
Note keeper
Witnesses J. LORSUNG

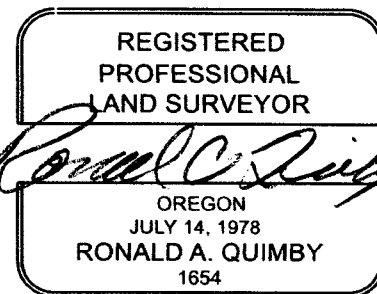

EXPIRES: 12/31/2022

CS 67/55-20

MM GPS 12/07/22
TIME - 12:48
H.L. - 2.000M

RENEWED 12/07/22

TOWNSHIP 25 RANGE 01 POINT IDENTIFIER # 540100

PRIMARY CORNER DESCRIPTION So 1/4 Cor for Sec 35 only

Alias _____	Description _____
Alias _____	Description _____
Alias _____	Description _____
Alias _____	Description _____

BLM dependent resurvey by Bryan S. Seibold, Cadastral Surveyors, under Group #1828, surveyed June/July 1997 - (DCSO records Vol. 53 Page(s) 20322-3)

DECLINATION 14 1/2 °E

The 1/4 sec. cor. of sec. 35 only, on the S. bdy., perpetuated by Gaylord, in 1977, monumented with an iron post, 1 1/2" diam., firmly set, projecting 3" above ground, with brass cap mkd.

FOUND BE MON. BURIED 2 1/2 FT. DEEP UNDER TREE TIP-OUT MOUND

COUNTY SURVEYORS OFFICE
T 25 S R 1 W
S 35 ONLY
1977

DIG AWAY TIP-OUT MOUND MON. NOW PROT. 2" ABOVE GROUND

from which the remains of an original bearing tree, defaced by Mensch and recorded by Gaylord

A sawed fir stump, 42" diam., bears S 02° E., 34 1/2 lks., with healed blaze (Record, 27 lks.)

and the remains of an original bearing tree and a root hole, bears N 70° W., 22 lks., with uprooted fir,

37" diam., no marks visible.

and a bearing tree by Mensch, 32 1/2 lks., with healed blaze (Record, N. 35° E., 146 lks.)

and a new bearing tree

of fir, 26" diam., bears N. 58° W., 40 1/2 lks., mkd. 1/4 S35 BT.

The cor. is located at the base of the root-wad from the original NW bearing tree.

From this point, the BLM, Geodetic Control Station No. EC41263, at latitude 43°21'09.370"N., longitude 122°46'13.840"W., (NAD 1983 (91)), determined by the NAVSTAR Global Positioning System, bears N.2°00'19"E., 15.071 chs. (mean bearing and sea level distance), monumented with an aluminum cap, firmly set flush with the ground, with top mkd. EC41263 GPS 1998.

NEW REF.

5/8" x 30° IR / DCSO YELLOW PLSTC. CAP

SET PROT. 4" IN EASTLY RD. SHLDR BEARS EAST 44°

MONUMENT IS ON MODERATE EAST SLOPE 100 FT. EAST OF RIDGE TOP ROAD AND ≈ 35 FT. WEST OF SPUR RD. RUNNING NORTH AND EAST.

CS 67 / 55-20

1911 01/10/12
TIME - 12:48
15.1 - 2,000M
TOWNSHIP 25 RANGE 01 POINT IDENTIFIER # 540100

PRIMARY CORNER DESCRIPTION So. 1/4 Cor. for Sec. 35 only

Alias _____ Description _____
Alias _____ Description _____
Alias _____ Description _____
Alias _____ Description _____

GLO survey by Hezekiah H. Johnson, Deputy Surveyor, under Contract #721, dated May 1, 1900 - (DCSO records Vol. 8 Page(s) 3501)

Set a Arbutus post 3 ft. long, 3" sq., 24" in the ground for 1/4 sec.cor. mkd. 1/4 S35 on N. and S2 on S. faces, from which
A Fir 14" dia., bears S.6 1/2°E., 27 lks. dist. mkd. 1/4 S2 BT.
A Fir 15" dia., bears N.70°W., 22 lks. dist. mkd. 1/4 S35 BT

GLO survey by Fred Mensch, Deputy Surveyor, under Contract #797, dated April 19, 1910 - (DCSO records Vol. 9 Page(s) 3571-72 (and duplicate Pg. 4079)

The 1/4 sec. cor. which is a post almost decayed by fire, marked and witnessed as described by the surveyor general. I re-establish the cor. in its original position as the 1/4 sec. cor. on S. bdy. sec. 35, T25S R1W only, as follows:
Set a basalt stone 15x10x10 ins., 10" in the ground for 1/4 sec. cor. on S. bdy. sec. 35, marked 1/4 on N. face, from which
A Fir 24" dia., bears N.35°E., 146 lks. dist. mkd. 1/4 S35 BT.
A Fir 18" dia., bears N.70°W., 22 lks. dist. mkd. 1/4 S35 BT.
I obliterate marks on former bearing tree referring to sec 2.

Dennis Gaylord, U.S. Forest Service (Deputized by the County) - Sept. 15, 1977 - C.S. File 59/40-13

Found - Stone, 15"x10"x10", marked "X" on top and "1/4" on N. face. Stone is firmly set in the ground.
Orig. 24" D.Fir now 38", bears N.35°E., 69.4 ft. (Rec. 96.4 ft.) with healed blaze.
Orig. 15" D.Fir now 41", bears N.70°W., 13.5 ft. (Rec. 14.52 ft.) with healed scar.
Placed DCSO tag on both, which are alive and well.
Orig. 14" D.Fir now 41", bears S.5°E., 22.8 ft. (Rec. S.6 1/2°E., 17.82 ft.) with healed scar. (Scribing supposedly destroyed by Mensch in 1910). Placed DCSO BT tag on tree.

Set Brass cap at cor. mkd: County Surveyors Office
T 25 S R 1 W
1/4 S 35
ONLY
1977

Buried stone alongside cap. Corner lies 100 ft. East of ridge top and old cat road.

continued next page

CS 67/55-20

4/4