

GOVERNMENT CORNER RESTORATION FORM

FILED

TOWNSHIP 27S RANGE 2W SEC. 5

PLSS # 200640

Date: 2/14/2023 By: SC

This survey consists of:

Map: _____

Narrative: _____

Corner Rpt: CS 67/5523

DOUGLAS COUNTY OREGON

DATE 1-12-23

DOUGLAS COUNTY
SURVEYOR

Corner Designation

1/4 COR 6/5

Monument(s) Found: (Condition and Source)

___ Condition report

___ Not Found

Renewed

___ Unrecorded

___ Surveyed In

DCSO BRASS CAP ON 1 1/4"

Iron pipe proj. 9"

Previous Renewals

DCSO 1969 CS 54/40-169

BLM Resurvey 1979 Vol 44

pg 16920

RICE 2011 M 162-6

MONUMENT DETAIL

County Surveyors
OFFICE

T 27S R 2W

1/4 56/55

1969

Accessories Found

Rotted - Burnt 44" X 35' FIR SWA9 SBOW 35.0 FT

15" D. FIR N 51 1/2° W 6.0 FT (REC 9 1/2 LKS 6.27 FT)

Fully healed BLAZE ADDED 3 1/2" MAG NAIL RIGHT
Side Center

21" D. FIR S 68 1/2° E 108.2 FT Healed SCAR

GALVANIZED Steel Lath North 0.5 Ft.

C.S. File 67/55-23

RENEWAL

Monument Set (Procedure and Description)

MONUMENT DETAIL

New Accessories

14" D. Fire S89°E 15.9 FT 3/4" Mag Nail
 RIGHT Side Center


Sketch of Monument, Accessories, and General Area

Location & Comments

LAT. 43°15'01.26" N
 LONG 122°58'17.00" W

COR. IS APPROX
 85' ENE OF
 END OF GRAVEL
 ROAD

Comp. Decline. 14 1/2° E
 Agency DCSO
 Party Chief S. F. HAUSE
 Note keeper
 Witnesses J. LORSUNG

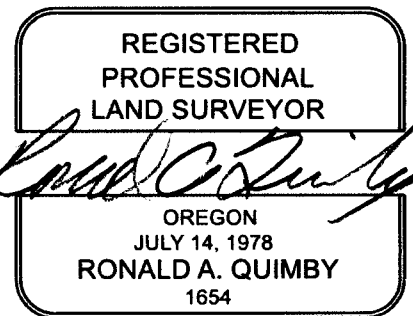

EXPIRES: 12/31/2024

MMGPS 1/12/23
TIME - 9:00
H.I. - 2.000M

RENEWED 1/12/23

TOWNSHIP 27 RANGE 02 POINT IDENTIFIER # 200640

PRIMARY CORNER DESCRIPTION 1/4 Cor. Secs. 5 & 6

| | |
|-------------|-------------------|
| Alias _____ | Description _____ |
| Alias _____ | Description _____ |
| Alias _____ | Description _____ |
| Alias _____ | Description _____ |

GLO Survey by Samuel C. Flint, Under Contract #459, dated Aug. 3, 1882 (DCSO Records Vol. 12 Page(s) 4883)

Set laurel post, 3 ft. long, 3" sq., 24" in the ground, for 1/4 sec. cor., marked 1/4 S on E & W faces; from which

A fir, 32" dia., bears S.60°E., 22 lks., mkd: 1/4 S BT.

A fir, 30" dia., bears S.80°W., 52 lks., mkd: 1/4 S BT.

Douglas Co. Surveyors Office - Vernon "Ray" Tracy - J. Heritage - V. Perron - June 4, 1969 - C.S. File 54/40-169

Found - OBTs as follows:

Orig. 32" now 38" fir S.60°E., 14.5 ft. Alive frag. bark scribe visible.

Orig. 30" now 48" fir S.80°W., 34.3 ft. Alive bark scribe "1/4 S BT" visible.

Set - At corner point set 1" IP, brass cap mkd:

COUNTY SURVEYORS T27S R2W
OFFICE 1969 1/4 S 6 | S 5

9" Pine N.49°E., 26.3 ft. mkd: 1/4 S5 CS BT.

8" D.Fir N.47°W., 6.4 ft. mkd: 1/4 S6 CS BT.

This cor. lies on Southerly slope in old growth timber.

BLM Dependent resurvey by Wayne Rogers, Cadastral Surveyor, under Group #983, surveyed May/Aug 1979 - (DCSO records Vol. 44 Page(s) 16920)

The 1/4 sec cor of secs. 5 & 6, perpetuated & recorded by Tracy in 1969, monumented with an iron post, 1 1/4" dia., firmly set, projecting 9" above ground, with brass cap (properly) mkd from which the remains of the orig. BTs ~~1452~~

A root hole, bears S.60°E., 22 lks., with sawed fir stump alongside, 38" dia., no marks visible.

A fir, 45" dia., bears S.80°W., 53 lks., with scribe marks ~~1/4 S BT visible on bark (Rec. 52 lks.)~~ ~~3428~~ MARKS GONE

and the remains of the BTs mkd. by Tracy ~~2640~~

A root hole, bears N.49°E., 40 lks., with a down pine, 12" dia., alongside, with healed double blaze. STUMP ROTTEN AWAY

LIVE 15" AD. fir, 10" dia., bears N.51 1/2°W., 9 1/2 lks. with scribe mark S visible on partially healed blaze. ~~627 60~~ TO 3 1/2 MAG. RSC

and a new BT NOW FULLY HEALED ~~10824~~

21" LIVE AD. fir, 5" dia., bears S.68 1/2°E., 164 lks., mkd: 1/4 S5 BT.

B&D - NOT CHECKED BEHIND NEW TREES

Fd. BC & 3 BTs by R. Rice 2/2011 - M162-6
GALVNIIZED STEEL LATH FND 0.5 FT NORTH

NEW REFS.
LIVE 14" D. FIR SET 3 1/2" MAG NA'L RSC. S89°E, 159 FT.

BC MON, 15 ≈ 85 FT ENE FROM END OF GRAVELLED FOREST RD.

STMP MOSTLY ROTTEN AWAY
ROOT HOLE INDISTINCT
ROTTED BURNED
SNAG 4 1/2" X 35"

CS 62 / 55-23
313