

GOVERNMENT CORNER RESTORATION FORM

FILED

TOWNSHIP 26S RANGE 3W SEC. 35 PLSS # 600 140

Date: 2/14/2023 By: X  
This survey consists of:

DOUGLAS COUNTY OREGON

DATE 1-18-23

Map: \_\_\_\_\_  
Narrative: \_\_\_\_\_  
Corner Rpt: CS 67/55-25

Corner Designation

1/4 COR 535/536

DOUGLAS COUNTY  
SURVEYOR

Monument(s) Found: (Condition and Source)

\_\_\_ Condition report

BLM BRASS CAP ON 2 1/2"  
OD ALUM post UP 4"

\_\_\_ Not Found

Renewed

\_\_\_ Unrecorded

Previous Renewals

\_\_\_ Surveyed In

BLM Resurvey 1981 Vol 45 pg 17435  
DCSD 2007 CS 67/24-51

MONUMENT DETAIL

T 26S R 3W  
1/4  
535/536  
1981

Accessories Found

mostly Burned away FIR stump S56°E 10.4 FT

Burned Rotted 12" G. FIR stub N87°W 11.2 FT

Burned FALLEN 14" X 4' R. Cedar stump  
N 5 1/2° E 9.4 FT

Burned DEAD 14" D. FIR S26W 6.2 FT Healed  
Double BLAZE ADD 3 1/2" MAG NAIL RIGHT  
Side Center

3/4" I.D IRON Pipe N56 1/2° E 63.7 FT (NO  
RECORD) projects 18"

C.S. File 67/55-25

---



---



New Accessories

Burnt Dead 20" D. Fir N40°W 24.2 FT  
 ADD 3 1/2" MAG NAIL RIGHT side center  
 Not Blazed or Scribed


Sketch of Monument, Accessories, and General Area

Location & Comments

OCRS State Plane Coord  
 System South Zone  
 Cottage Grove - Canyonville  
 N 159192.659  
 E 250156.469

AREA BURNED  
 9-2020

Comp. Decline. 14 1/2° E  
 Agency DCSO  
 Party Chief S FIAUSE  
 Note keeper  
 Witnesses J. LORSUNG

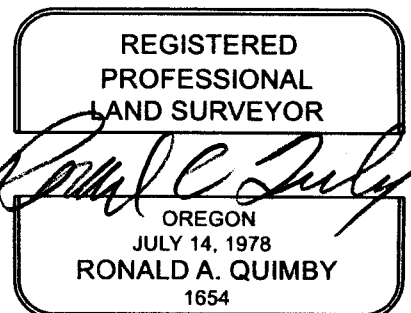

EXPIRES: 12/31/2024

CS 67/55-25

N - 157192.659  
E - 250156.469

TOWNSHIP 26 RANGE 03 POINT IDENTIFIER # 600140

PRIMARY CORNER DESCRIPTION 1/4 Cor. Secs. 35 and 36

Alias _____	Description _____
Alias _____	Description _____
Alias _____	Description _____
Alias _____	Description _____

Original - L.L. Williams & A.R. Flint, under Contract #151 dated May 23, 1871 (DCSO Records, Volume 10 Page 4375)

-----

Set post for 1/4 sec. cor., from which  
 A Fir 30" dia., bears S.45°E., 14 lks. dist.  
 A Fir 15" dia., bears N.75°W., 45 lks. dist.

Bureau of Land Management Dependent Resurvey by Wayne L. Rogers under Group #1058 - Survey June/Aug. 1981 (DCSO Records Volume 45 Page 17435)

-----

1/4 Corner determined at record bearing and distance from the remains of the original bearing trees:  
 A sawed fir stump 40" dia., bears S.45°E., 14 lks. dist., with axe marks visible on decayed blaze.  
 A decayed fir stump 24" dia., bears N. 75° W., 45 lks. dist., no marks visible.

At the corner point  
 Set an alum. post, 28 ins. long, 2 1/2 ins. diam., 22 ins. in the ground, with aluminum cap mkd.

T 26 S R 3 W  
 1/4  
 S 35 | S 36  
 1981

from which new bearing trees  
 A fir 6" dia., bears S.24 1/2°E., 8 1/2 lks. mkd. 1/4 S36 BT.  
 A fir 6" dia., bears N.87°W., 17 lks. mkd. 1/4 S35 BT.

Douglas Co. Surveyors Office - John Pike - Stephen J. Flause - 12/5/2007 - C.S. File 67/24-51

-----

Found - 3 1/4" dia., alum cap, properly marked on 2 1/2" O.D. alum post, firmly set, projects 4" above ground.

*MOSTLY BURNED AWAY* 40" now indeterminate dia., x 2 ft. tall very rotted fir stump, evidence of sawn open blaze bears *GONE* S.56°E., 10.4 ft. (Rec. S.45°E., 9.2 ft.) OBT

*BURNED ROTTED STUB* - 6" now 12" dia., G. Fir, healed double blaze bears N.87°W., 11.2 ft. (agrees w/rec.) 1981 BT

*NO EVID* - 6" now 9" dia., uprooted windfall D. Fir fully healed double blaze, root hole agrees well w/rec (S.24 1/2°E., 5.6 ft.) 1981 BT *BLAZE BURNED OUT GONE*

*BURNED! FALLEN SHATTERED* New - Double trunk R. Cedar, southerly trunk is 14" dia. & is scribed "1/4 S36 CS BT" bears N.5 1/2°E., 9.4 ft

*BURNED DEAD 14"* - 14" dia., D. Fir, double blazed & scribed "1/4 S35 CS BT" bears S.26°W., 6.2 ft. *FHOB*

continued next page ADD 3 1/2" MAG NAIL R.S.C.

TOWNSHIP 26 RANGE 03 POINT IDENTIFIER # 600140

PRIMARY CORNER DESCRIPTION 1/4 Cor. Secs. 35 and 36

Alias \_\_\_\_\_ Description \_\_\_\_\_  
Alias \_\_\_\_\_ Description \_\_\_\_\_  
Alias \_\_\_\_\_ Description \_\_\_\_\_  
Alias \_\_\_\_\_ Description \_\_\_\_\_

3/4" I.D. iron pipe, fd, projects 18" above ground  
bears N.56 1/2° E., 63.7 ft. (NO record)  
Note - Corner lies near base of mountain with mature timber  
to west & young timber plantation to east.

NEW REFS

BURNED DEAD 20" D. FIR N40°W, 34 2/3, PLACE 3 1/2" MAG NAIL R.S.C.

CS 67/55-25

414