

GOVERNMENT CORNER RESTORATION FORM

FILED

TOWNSHIP 26S RANGE 3W SEC. 12 PLSS # 670540

Date: 2/14/2023 By: X
This survey consists of:

DOUGLAS COUNTY OREGON

DATE 1-24-23

Map: _____
Narrative: _____
Corner Rpt: CS 67/22-28

Corner Designation

CW 1/16 S 12

DOUGLAS COUNTY
SURVEYOR

Monument(s) Found: (Condition and Source)

___ Condition report

___ Not Found

Renewed

___ Unrecorded

___ Surveyed In

DCSD BRASS CAP

Proj 8"

Previous Renewals

DCSD 1978 CS 60/7 M 65-73

DCSD 2008 CS 67/25-20

MONUMENT DETAIL

Douglas Co
Surveyor
T26S
C W 1/16 C
S12
R3W
1978

Accessories Found

BURNED Out Shell 18" X 8" Red Cedar

N 1°W 37.3 FT

28" X 30 FT Burned SNAG S83°E 101.9 FT

Healed Upper BLAZE Lower BLAZE BURNED Out.

C.S. File 67/55-28

Monument Set (Procedure and Description)

MONUMENT DETAIL

New Accessories

12" X 2 1/2' SAWN BURNED MAPLE STUMP S 72° E
22.0 FT 3 1/2" MAG NAIL TOP CENTER

11" X 13 FT BURNED BROKEN TOP FIR SNAQ
S 5 1/2° W 21.5 FT 3 1/2" MAG NAIL RIGHT SIDE
CENTER

12" X 1 1/2 FT BURNED SAWN FIR STUMP S 42° W
13.0 FT 3 1/2" MAG NAIL RIGHT SIDE CENTER


Sketch of Monument, Accessories, and General Area

Location & Comments

Lat: 43° 19' 20.59" N
Long: 123° 00' 23.11" W

AREA BURNED
9-2020

Comp. Decline. 14 1/2° E
Agency DCSO
Party Chief S F/HAUSE
Note keeper
Witnesses J. LORSUNG

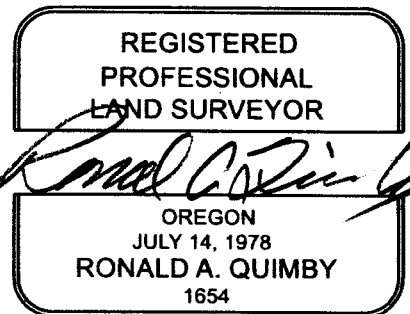

EXPIRES: 12/31/2024

MM GPS 12/05/22
TIME = 12:40
Kil - 2.000M

RENEWED 1/24/23

TOWNSHIP 26 RANGE 03 POINT IDENTIFIER # 620540

PRIMARY CORNER DESCRIPTION West Center 1/16, Sec. 12

Alias _____	Description _____
Alias _____	Description _____
Alias _____	Description _____
Alias _____	Description _____

Doug. County Surveyors Office - Gary Langlitz; L.E. Monrean
S.J. Flause; Frank Silagy - March, 1978 - C.S. file 60/7
M 65-73

Corner location determined by survey.

Set - At the corner point WE SET a 1" x 30" I.P. 27" in
the ground with brass cap attached marked:

Douglas Co. Surveyor	T 26 S	✓	PROT 8"
1978	W 1/16		
	C	S 12	C
		R3W	

BURNED OUT SHELL 18" x 8 FT TALL
TOP BURNED OFF 28" x 30 FT. SNAG 24" AND TRUNK BURNED

16" Red Cedar scribed "CW 1/16 S12 CS BT" on a double blaze, bears N.1°W, 37.3 ft.
D. Fir scribed "CWS 1/16 S12 CS BT" on a double blaze bears S.83°E, 101.9 ft.

TREE HOLLOWHEAD OUT NO BLZ. EVID.
HEALED UPPER BLZ. LOWER BLZ. BURNED OUT

Corner located along E-W cutting line approx. 200 ft. west of small creek.

FD. Ok, Red Cedar OK, D. Fir now 30 ft. tall snapped off but still alive - DCSO 2/26/2008, J. Pike & S. Flause, C.S. File 67/25-20

NEW REFS

12" x 2 1/2" SAWN BURNED MAPLE STUMP 3 1/2" MAG NAIL TOP CNTR. S72°E, 22° FT.

11" x 13 FT BURNED BROKEN TOP FIR SNAG 3 1/2" MAG NAIL S05 1/2° W, 21 1/2 FT
R.S.C.

12 x 1 1/2 FT. BURNED SAWN FIR STUMP 3 1/2" MAG NAIL S42° W, 13° FT
R.S.C.