

GOVERNMENT CORNER RESTORATION FORM

FILED

TOWNSHIP 255 RANGE 3W SEC. 3 PLSS # 440646

Date: 2/14/2023 By: X

This survey consists of:

Map: _____

Narrative: _____

Corner Rpt: CS 67/55-29

DOUGLAS COUNTY OREGON

DATE 1-26-23

DOUGLAS COUNTY
SURVEYOR

Corner Designation

C 1/4 S 3

Monument(s) Found: (Condition and Source)

3/4" BLM BRASS CAP

___ Condition report

___ Not Found

Renewed

___ Unrecorded

___ Surveyed In

Previous Renewals

BLM set in 1987 No 148
p9 18489 projecting 4"
From Rough Stonemound

MONUMENT DETAIL

T 255 R 3W
C 1/4
S 3
1987

Accessories Found

BURNED DEAD 9" D. Fir 574°E 9.0 FT (REC
570°E 9.6) Fully Healed Double BLAZE
ADD 3 1/2" MAG Nail RIGHT Side Center

C.S. File 67/55-29

New Accessories

5/8" X 30" I. ROD S 66° E 36.5 FT WITH DCSO
yellow PLASTIC CAP 4"

5/8" X 30" I. ROD S 69° W 12.2 FT WITH DCSO
yellow plastic CAP 4"

Burned DEAD 16" D. FIR N 23 1/2° W 24.2 FT
Not BLAZED or Scribed 3 1/2" MAG NAIL
RIGHT SIDE CENTER

Sketch of Monument, Accessories, and General Area


Location & Comments

monument on relative
flat, large bench 50±
south of top south bank
of west running ravine
tributary north fork of
Hinkle Creek

AREA BURNED
9/2020

Comp. Decline. 14 1/2° E
Agency DCSO
Party Chief S. Krause
Note keeper
Witnesses J. Lossing

Lat 43° 25' 42.58" N
Long 123° 02' 15.71" W

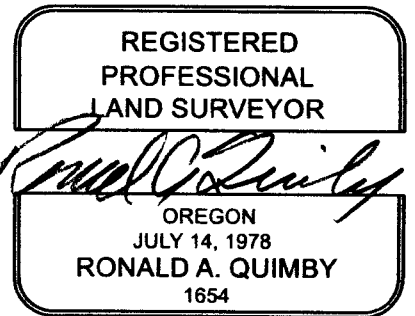

EXPIRES: 12/31/2024

CS 67/55-29

TOWNSHIP 25 RANGE 03 POINT IDENTIFIER # 440640

PRIMARY CORNER DESCRIPTION Center 1/4 cor for Sec 3

Alias	Description
Alias	Description
Alias	Description
Alias	Description

Bureau of Land Management survey of Subdivision Sec. 3 Wayne Rogers, et al - Under Group #1386 - Survey, June 1987 to Sept. 19, 1988 (DCSO records, Volume 48 Pg 18489)

Point for the center 1/4 sec. cor. of sec. 3, at intersection with the E. and W. center line.

Set a stainless steel post, 28" long, 2 1/2" dia., 22" in the ground, in a collar of stone, with brass cap mkd.

3 1/4" B.C. PROPERLY MKD T 25 S R 3 W C 1/4

PROT 6" FROM ROUGH MOUND OF STONE

S 3 1987 574°E 9.0 9.57

from which

BURNED DEAD 9" AD FIR
FALLEN, BURNED 24" x 40" AD FIR
BROKEN SNAG

X at breast height and BT at the base. FHDB

9" AD FIR 20" dia., bears S 20° W. 16 lks. dist., mkd.

C 1/4 S3 BT. FH SB

POSITION GONE 10-56 ROOTHOLE GONE GROUND DISTURBED
ADD 3 1/2" MAGNAIL R.S.C.

Deposit a white "DEEP-1" magnetic marker at the base of the stainless steel post.

NE REFS

5/8" IRON ROD / YELLOW PLSTC DCSO, PROT 4"; BEARS S66°E, 36.5 FT. CAP

" " " " ; BEARS S64°W, 12.2 FT.

BURNED DEAD 16" D. FIR NOT BLZD, DR SCRBD BEARS N23 1/2° W, 24.2
3 1/2" MAGNAIL R.S.C.

MONUMENT ON, RELATIVELY FLAT, LARGE BENCH ~ 50 FT. SOUTH FROM TOP OF SOUTH BANK OF WEST RUNNING RAVINE (NORTH FORK HINKLE CRK, TRIBUTARY)