

GOVERNMENT CORNER RESTORATION FORM

FILED

TOWNSHIP 26S RANGE 2W SEC. 14 PLSS # 540400

Date: 2/28/2023 By: JC
This survey consists of:

DOUGLAS COUNTY OREGON

DATE 1-19-23

Map: _____

Narrative: _____

Corner Rpt: CS 67/55-31

Corner Designation

1/4 COR 14/23

DOUGLAS COUNTY
SURVEYOR

Monument(s) Found: (Condition and Source)

3 1/4" BRASS CAP ON 2" IRON
PIPE UP 6"

___ Condition report

___ Not Found

Renewed

___ Unrecorded

___ Surveyed In

Previous Renewals

GLO Resurvey 1916 Vol 10 pg 430b
BLM Resurvey 1975 Vol 46
pgs 15725-6

MONUMENT DETAIL

T26S R2W

1/4 514
523
1975

Accessories Found

SAWN 24" X 1' D FIR STUMP N40W 37.5 FT
TO 3 1/2" MAG NAIL SET TOP CENTER

TIPPED OUT SAWN 30" X 8' D. FIR STUMP
S56W 64.4 FT TO ROOT HOLE

LIVE TREE BURIED DEAD 13" FIR ~ SOUTH

C.S. File 67/55-31

RENEWAL

Monument Set (Procedure and Description)

MONUMENT DETAIL

New Accessories

Singed 20" I. Cedar N57°E 47.5 FT
 Not BLAZED or Scribed 3 1/2" MAG NAIL
 RIGHT Side Center

Singed 13" I. Cedar S75°E 45.8 FT
 Not BLAZED or Scribed 3 1/2" MAG NAIL RIGHT
 Side Center

SAWN 13" X 1 1/2 FT D. FIR Stump N59 1/2° W
 41.0 FT 3 1/2" MAG NAIL Top Center


Sketch of Monument, Accessories, and General Area

Location & Comments

LAT 43°17' 57.26" N
 LONG 122° 54' 12.43" W

AREA BURNT
 9-2020

Comp. Decline. 14 1/2° E
 Agency DCSD
 Party Chief S. Finuse
 Note keeper
 Witnesses J Lorusung

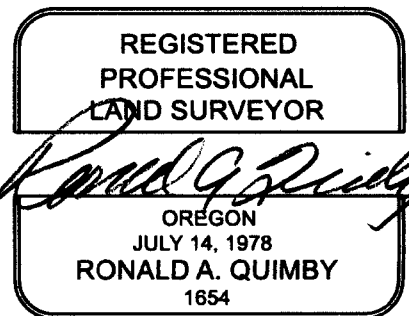

EXPIRES: 12/31/2024

CS 67/55-31

MMGPS 1/19/23
 TIME - 12:05
 H.I. - 2,000M

RENEWED 1/19/23

TOWNSHIP 26 RANGE 02 POINT IDENTIFIER # 540400

PRIMARY CORNER DESCRIPTION 1/4 Cor. Secs. 14 & 23

Alias _____ Description _____
 Alias _____ Description _____
 Alias _____ Description _____
 Alias _____ Description _____

GLO survey by John A. McQuinn, Deputy Surveyor, under contract No. 466, dated April 5, 1883 - (DCSO records Vol. 10 Page(s) 4200)

Set hemlock post, 3 ft. long, & 3" sq., 24" in the ground for the 1/4 sec. cor. marked 1/4 S on N face, from which:
 A fir, 12" dia., bears S.50°E., 17 lks., mkd: 1/4 S BT.
 A fir, 12" dia., bears N.20°W., 15 lks., mkd: 1/4 S BT.

GLO resurvey by Fred Mensch, U.S. Cadastral Engineer; under Instructions dated May 25, 1916 & April 16, 1918, - (DCSO records Vol. 10 Page(s) 4306)

Intersect the 1/4 sec. cor., established by McQuinn in 1883 and re-established by U. S. Surveyor Collier in 1913*, which is a basalt stone, 5x8x8", above ground firmly set, marked 1/4 on N face, from which
 A fir, 18" dia., bears S.59°E., 17 lks. Marked 1/4 S23 BT (Orig. BT)
 A fir, 18" dia., bears N.15°W., 15 lks. Marked 1/4 S14 BT (Orig. BT)
 *Note - (I can not find any record of Collier's resurvey 10/11/2007 DCSO JC)

BLM dependent resurvey by G. Steven Popken, Cadastral Surveyor, Group No. 871, surveyed June/Sept. 1975 - (DCSO Vol. 46 Page(s) 15725-6)

The 1/4 sec. cor. of secs. 14 & 23, determined at record bearing & distance, from the remain^{#22} of the orig. BTs:

~~GONE~~ - A root hole, bears S.59°E., ~~17~~ lks., with a down fir alongside, 20" dia. with scribe marks 1/4 S23 BT visible on opened blaze. ~~GONE~~

At the corner point
 Set an iron post, 28" long, 2 1/2" dia., 24" in the ground, with brass cap mkd. T26S R2W 1975

from which new BTs
 A fir, 13" dia., bears N.4°W., 37 1/2 lks., mkd: 1/4 S14 BT.
 A fir, 14" dia., bears S.66°W., 16 1/2 lks., mkd: 1/4 S23 BT. FH TO ROOT HOLE

FOUND LINE TREE BURNED DEAD 13" FIR S SOUTH

NEW REFS,
 SINGED ALIVE 20" I. CEDAR NOT BLAZED BEARS N 57° E, 47 1/2 3 1/2" MAG NAIL R.S.C.
 " " 13" I. CEDAR " " " 57 1/2° E, 45 1/2 " " " 1

SAWN 13" x 1 1/2 FT D. FIR STUMP 3 1/2" MAG NAIL TOP CNTR N 59 1/2° W, 41 1/2 FT

SAWN STUMP 24" x 1 FT.
 TIPPED OUT
 SAWN OFF 30" x 8 FT. STUMP

CS 67/55-31 3/3