

TOWNSHIP 26S RANGE 2W SEC. 10

PLSS # 500500

Date: 2/28/2023 By: JC
This survey consists of:

DOUGLAS COUNTY OREGON

DATE 1-25-23

Map: _____
Narrative: _____
Corner Rpt: CS67/55-33

Corner Designation

sec COR 10/11
15/14

DOUGLAS COUNTY
SURVEYOR

Monument(s) Found: (Condition and Source)

3 1/4" BLM BRASS CAP ON
2 1/2" PIPE UP 2" IN LARGE
ROUGH MOUND OF STONE

Previous Renewals

DCSO 1927 CS 14/31

BLM RESURVEY 1959 Vol 30 pg 1272-7

DCSO 1961 CS 52/77-9

Quimby 2001 M 139-15

BLM 1968 Vol 34 pg 14276-7

BLM 1992-1995 Vol 51 pg 19750-1

BLM 2018-2020 Vol 59 pg 24057

___ Condition report
___ Not Found
 Renewed
___ Unrecorded
___ Surveyed In

MONUMENT DETAIL

T26S R2W

510/511

515/514

1959

Accessories Found

BURNED DEAD 12" D. FIR N 55° E 23.8 FT HEALED
BLAZE ADD 3 1/2" MAG NAIL RIGHT SIDE CENTER
BURNED DOWN 9" X 1 FT MADRONE STUMP N 72 1/2° E
48.8 FT BLAZE GONE

BURNED DEAD 16" D FIR S 52° E 32.0 FT (REC 31.0 FT)
WITH HEALED BLAZE ADD 3 1/2" MAG NAIL RIGHT SIDE
CENTER

BURNED DEAD 18" D. FIR BEARS (S 79° 14' W 121.4 FT
REC NOT CHECKED) WITH HEALED BLAZES

BURNED HOLLOWED OUT BROKE-TOP LIGHTNING
STRUCK 40" FIR N 40° 1/4 W 10.6 FT MARKS

BURNED AWAY

BURNED - DEAD 12" D. FIR S 83 1/2° E 20.5 FT
(REC 19.7 FT) NO MARKS VISIBLE ADD 3 1/2" MAG
NAIL RIGHT SIDE CENTER

BURNED GR STUMP S 23 1/4° E 65.3 FT

C.S. File 67/55-33

RENEWAL

Monument Set (Procedure and Description)

MONUMENT DETAIL

New Accessories


Sketch of Monument, Accessories, and General Area

Location & Comments

LAT 43°18'49.72"N
 LONG 122°54'45.97"W

AREA BURN +
 9/2020

Comp. Decline. 14 1/2° E
 Agency DE 50
 Party Chief S. F. HAUSE
 Note keeper
 Witnesses J. LORSUNG

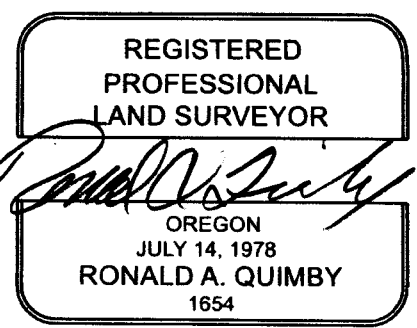

EXPIRES: 12/31/2024

CS 67/55-33
 2/4

MM GPS - 1/25/23
TIME - 9:40
H.L. - 2.000M

RENEWED 1/25/23

TOWNSHIP 26 RANGE 02 POINT IDENTIFIER # 500500

PRIMARY CORNER DESCRIPTION Cor Secs 10, 11, 14, & 15

Alias _____	Description _____
Alias _____	Description _____
Alias _____	Description _____
Alias _____	Description _____

and the remains of BTs mkd. by Godfrey
 A madrone stump, 8" dia., bears N.72½°E., 74 lks., with reverse scribe marks BT visible. (Record, N.73°E.)
 A sawed maple stump, 5" dia., bears S.85¾°E., 45 lks., with decayed maple alongside, with scribe marks BT visible on opened blaze. (Record, S.86°E.)
 A fir, 12" dia., bears S.79¾°W., 184 lks., with healed double blaze. (Record, 184½ lks.)
 and new bearing trees
 A fir, 7" dia. bears N.55°E., 36 lks. mkd. T26S R2W S11 BT
 A fir, 10" dia. bears S.52°E. 47 lks. mkd. T26S R2W S14 BT
 From the sec corner, the BLM, Geodetic Control Station No. EC 41166, at latitude 43°18'50.0488"N longitude 122°54'39.1635"W (NAD 1927), determined by the NAVSTAR GPS, bears S.83°07'48"E., 2.883 chs. (mean bearing & sea level dist); monumented with an aluminum cap, ¾" dia., set in concrete in bedrock, with cap mkd. EC41166 GPS 1992 and a triangle.

BLM dependent resurvey by Jeffrey O. Covington, Cadastral Surveyor, under Group No. 2923, surveyed July 2018/March 2020- (DCSO records Vol. 59 Pages 24057)

The cor. of secs. 10, 11, 14, & 15, reported by Bedell, Seibold, and Browning in 1992-95, monumented with an iron post, 2½" dia., firmly set, projecting 16" above ground, in a mound of stone, 2 ft. base, 12" high, with a brass cap (properly) mkd. *3 1/4" B.C. ON 2 1/2" PIPE PROPLY MRKD PROT. 2" FROM LARGE ROUGH MOUND OF STONE*

BURNED DEAD 12" AD fir, 12" dia., bears N.55°E., 23.8 ft., with a healed blaze. *ADD 3 1/2" MAG NAIL R.S.C.*

BURNED DOWN TO 9" X 1 FT. A madrone stump, 10" dia., bears N.72½°E., 48.8 ft., with no marks visible on open blaze. *BLAZE GONE*

NOW BURNED A decayed fir stump, 26" dia., bears S.22¾°E., 65.3 ft., no marks visible. (Original) *320*

BURNED DEAD 16" AD fir, 15" dia., bears S.52°E., 31.0 ft., with a healed blaze. *ADD 3 1/2" MAG NAIL R.S.C.*

GONE A decayed fir stump, 30" dia., bears S.27¼° W., 37.0 ft. with a healed blaze. (Original) *NOT CHK'D NEW TREES WILL HIDE FROM COR*

BURNED DEAD 18" AD fir, 18" dia., bears S.79¾°W., 121.4 ft., with a healed blaze. *ADD 3 1/2" MAG NAIL R.S.C.*

BURNED HOLLOWED OUT A broken-top lightning-struck living fir, 40" dia., bears N.40¾°W., 10.6 ft with ~~axe marks visible on bark~~ (Orig) *MARKS BURNED AWAY*

BURNED DEAD 12" AD fir, 12" dia., bears S.83¾°E., 19.7 ft., no marks visible and a bearing tree tag. *205*

Continued next page

CS 67/55-33

TOWNSHIP 26 RANGE 02 POINT IDENTIFIER # 500500

PRIMARY CORNER DESCRIPTION Cor. Secs. 10, 11, 14, & 15

Alias _____	Description _____
Alias _____	Description _____
Alias _____	Description _____
Alias _____	Description _____

NAD 1983 (2011)
Latitude: 43°18'49.71" N. Longitude: 122°54'45.90" W.
From this cor., the BLM Geodetic Control Station No. EC 41166, bears S.83°07'48"E., 190.28 ft., monumented with an aluminum cap, 3/4" dia., cemented in solid bedrock, with top mkd. EC41166 GPS 1992 and a triangle in the center.
Corner is located in the bottom of a shallow draw, drains S.55°E.

SIMON TALCOTT
541-637-7699
CALL BACK WHEN DONE

CS 67/55-33
4/4