

GOVERNMENT CORNER RESTORATION FORM

FILED

TOWNSHIP 26S RANGE 2W SEC. 16 PLSS # 300417

Date: 2/29/2023 By: SC
This survey consists of:

DOUGLAS COUNTY OREGON

DATE 1-25-23

Map: _____
Narrative: _____
Corner Rpt: CS 67/55-34

DOUGLAS COUNTY
SURVEYOR

Corner Designation

517 | 516
2 | TR37

Monument(s) Found: (Condition and Source)

BLM BRASS CAP IN ROUGH
STONE MOUND 2 1/2 FT. DIA.
X 1 1/2 FT HIGH

Previous Renewals

BLM RESURVEY 1959 Vol 30 pg 12737
DCSD 1973 CS 56/25-10
DCSD 1984 CS 62/21-12
LANG 2013 CS 65/79-17
Badgley 2021 M 179-27

___ Condition report
___ Not Found
 Renewed
___ Unrecorded
___ Surveyed In

MONUMENT DETAIL

T26S | 516
R2W | 2
517 | TR37
1918

Accessories Found

BURNED SAWN 30" X 0.5 FT D. FIR STUMP
N 93° E 36.0 FT (REC 36.9 FT) TO 3 1/2" NAG NAIL
ADDED TO TOP CENTER BLAZE SAWN OFF
1" I. D. IRON PIPE WITH B.T.S PLASTIC CAP
N 2° E 22.0 FT (REC N 1° 57' 17" E 22.09 PER
M 179-27)
Steel Fence Post N 22° E 2.6 FT

C.S. File 67/55-34

RENEWAL

Monument Set (Procedure and Description)

MONUMENT DETAIL

New Accessories

5/8" X 30" Iron Rod with DCSO yellow Plastic
CAP N70E 18.8 FT up 6"

5/8" X 30" Iron Rod with DCSO yellow Plastic
CAP N83°W 13.6 FT up 6"


Sketch of Monument, Accessories, and General Area

Location & Comments

LAT. 43°18'06.23" N
LONG 122°57'07.99" W

CORNER IS BETWEEN
N. Umpqua Hwy &
N. Umpqua River
ACROSS Hwy FROM OLD
FRONTIER STORE

AREA BURD 9/2020
Comp. Decline. 14 1/2° E
Agency DCSO
Party Chief S. Fause
Note keeper
Witnesses J. Lorsung

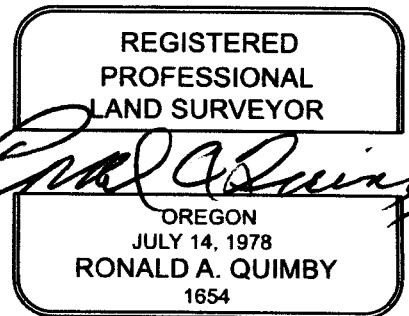

EXPIRES: 12/31/2024

CS 67/55-34

PRIMARY CORNER DESCRIPTION NW 1/4 Tract 37 (Cor #2)

Alias _____	Description _____
Alias _____	Description _____
Alias _____	Description _____
Alias _____	Description _____

GLO resurvey by Fred Mensch, U.S. Cadastral Engineer; under Instructions dated May 25, 1916 & April 16, 1918, - (DCSO records Vol. 10 Page(s) 4337)

Intersect W bdy of sec. 16 & temp. tract cor.
 At the point of intersection
 Set an iron post, 3 ft long, 1" dia., 26" in the ground for cor. No. 2 of Tract 37, with brass cap mkd:

T26S	S16
R2W	2
S17	TR 37
1918	

from which
 A fir, 42" dia., bears S.42°E., 90 lks., mkd: 2 TR 37 BT.

BLM dependent resurvey by Irving Zirpel, Jr. & Wm. Glenn, Cadastral Surveyors, Group No. 404, surveyed May/Oct. 1959 - (DCSO Vol. 30 Page(s) 12737)

Cor. No. 2 of Tract 37, on the E bdy. of sec. 17, monumented with an iron post, 1" dia., protruding 6" above ground, firmly set, marked & witnessed as described in the official record.

Douglas Co. Surveyors Office - John Powell - Jack Heritage - 4/13/1973 - C.S. File 56/25-10

Found - 1918 GLO brass cap buried in silt.
 42" D. Fir now stump S.42°E., 59.4 ft. scribing cut off, part of face left.
 New BT - 37" Maple, S.33°E., 43.3 ft. scribed 2 T37 CS BT.
 Note - This initial point of North Umpqua Village (not found by B. Barnes)

Douglas Co. Surveyors Office - Randall Smith - Stephen Flaue - Dec. 19, 1984 - C.S. File 62/21-12

Found - A 1918 U.S. GLO disk on an I.P. protruding 21" above ground properly marked. *ROUGH MOUND OF STONE (SEE BELOW)*

GONE NO EVID. - 42" now a 31" dia. 2½ ft. high decayed fir stump, no scribing or face found bears S.42°E., 59.4 ft. (Orig.)

ROTTEN LOOSE ON GROUND NO POSITION 37" dia. maple with partially healed single blaze, illegible scribing visible bears S.33°E., 43.3 ft. 1973

Set - 2½ ft dia., 1½ ft. high mound of stone around IP
 New BTs- 11" D. fir with a double blaze scribed "2 TR 37 CS
GONE NO EVID. - BT" bears S.70°E., 45.2 ft. continued next page

RENEWED
1/25/23

TOWNSHIP 26 RANGE 02 POINT IDENTIFIER # 300417

PRIMARY CORNER DESCRIPTION NW 1/4 Tract 37 (Cor. #2)

Alias _____	Description _____
Alias _____	Description _____
Alias _____	Description _____
Alias _____	Description _____

BURNED, SAWN 30" x 0.5 FT 13" dia. D. ✓ fir with a double blaze scribed "2-TR-37" BLAZE GONE
 STUMP ~~CS BT~~ bears N.43°E. ✓ 36.9 ft. 36° TO 3 1/2" MAG NAIL TOP CNTR. SAUN OFF

Corner lies between North Umpqua Hwy and N. Umpqua River across Hwy from Frontier Store.

FD. Mensch BC, by G Lang, 11/2013 - C.S. file 65/79-17
 Fd BC by R Badgley, 4/2021 - M179-27

NEW REFS.
 ~
 ~
 ~

5/8" x 30" IR/DCSO YELLOW PLSTC CAP PROT. 6" N 70° E, 188
 " " " " " N 83° W, 136

ALSO FOUND:

FROM SURVEY M179-27 1" I.D.I.P/BTS PLSTC CAP BEARS N 02° E, 220
 PROTRUDES 1 FT. (REC. N 01° 57' 17" E, 220)
 M 179-27

STEEL FNC POST N 22° E, 26 FT.