

TOWNSHIP 24S RANGE 3W SEC. 21 PLSS # 400340

Date: 2/28/2023 By: X
This survey consists of:

DOUGLAS COUNTY OREGON

DATE 2-2-23

Map: _____

Narrative: _____

Corner Rpt: CS 67/55-36

Corner Designation

1/4 COR S21/S22

DOUGLAS COUNTY
SURVEYOR

Monument(s) Found: (Condition and Source)

3'14" BLM BRASS CAP
UP 3"

___ Condition report

___ Not Found

Renewed

___ Unrecorded

___ Surveyed In

Previous Renewals

BLM 1962-1963 1/01 22 pg 13383

Hoffine 2009 CS 65/66-39

MONUMENT DETAIL

T26S R3W

1/4

S21/S22

1962

Accessories Found

Base Singed 44" D. Fire S25°W 104.94 FT
Fully Healed Single BLAZE

Sawn Singed 30" x 4' D. Fire Stump
S43'14° E 22.0 FT (Rec 22.1 FT) Blaze Burnt Out

Burnt - Dead 24" D. Fire N41'2° W 36.8 FT
(Rec N41'2° E 36.8 FT Fully Healed Single BLAZE)

RENEWAL

Monument Set (Procedure and Description)

MONUMENT DETAIL

New Accessories

5/8" x 30" Iron Rod with yellow Douglas
County Surveyors office plastic cap
N 50° E 20.9 FT up 7"

Sketch of Monument, Accessories, and General Area

Location & Comments


OCRS COORDINATE SYSTEM
Cottage Grove - Canyonville
Zone

CORNER ON NORTH
SLOPE APPROX 150'
NORTH OF ROAD

N 167851.004
E 239552.428

AREA BURNED
9-2020

Comp. Decline. 14 1/2° E
Agency DCSD
Party Chief S. F. RUSE
Note keeper
Witnesses J. LORSUM

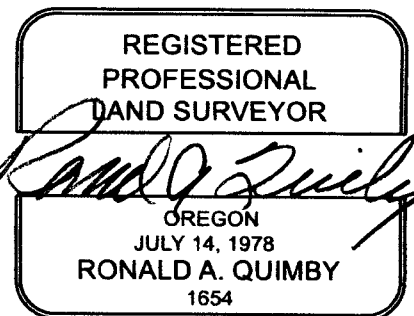

EXPIRES: 12/31/2024

CS 67/55-36

2/3

RTK 2/1/23 ORCS CANYONVILLE
GPS 167851.004N 239552.428E

RENEWAL 2/2/23

TOWNSHIP 26 RANGE 03 POINT IDENTIFIER # 400340

PRIMARY CORNER DESCRIPTION 1/4 Cor. for Secs. 21 and 22

| | |
|-------------|-------------------|
| Alias _____ | Description _____ |
| Alias _____ | Description _____ |
| Alias _____ | Description _____ |
| Alias _____ | Description _____ |

Original - Addison R. Flint, Contract #55 dated March, 1855
(DCSO Records, Volume 10 Pages 4355)

Set 1/4 sec. post, from which
A Cedar 8" dia., bears S.83°E., 19 lks. dist.
A Red Fir 36" dia., bears S.58°W., 52 lks. dist

Bureau of Land Management resurvey by Beck, White and Reynolds
Group #'s 242, 491, 527. Survey dated June 1962-Aug. 1963
(DCSO records, Vol. 32 Page 13383)

Point for the 1/4 sec. cor., at proportionate distance; there
is no remaining evidence of the original corner.
Set an iron post, 28" long 2 1/2" dia., 26" in the ground, with
brass cap marked: T 26 S R 3 W

S 21 | S 22
1962

from which **3 1/4 BC PROT. 3"**
A Fir 20" dia., bears S.72 1/2°E., 32 lks., mkd. 1/4 S22 BT.
A Fir 16" dia., bears S.25°W., 159 lks., mkd. 1/4 S21 BT.

Ken Hoffine - For: Lone Rock Timber Co. - Gary Angiolet &
Iginaco Roman - 9/2/2009 - C.S. File 65/66-39

Found - BLM BC 0.3 ft. above ground. **POS. ROOTHOLE**
GONE 20" Tall stump bears S.72 1/2°E., 20.9 ft. (record
S.72°E., 21.12 ft.) healed face and tag.
BASE SINGED ALIVE 44" 24" D. Fir bears S.25°W., 104.94 ft. per record did
not measure healed face and tag. **FHSB**
SAWN SINGED New **30" x 4"** D. Fir bears S.43 1/4°E., 22.1 ft. we scribe 1/4 S22
STUMPF BT and tag. **W 36 B - 229** **BLADE BURNED CUT**
BURNED DEAD 24" - 16" D. Fir bears N.41 1/2°E., 37.5 ft. we scribe 1/4 S21
BT and tag. **FHSB**

Note - Corner lies on north slope approx. 150 feet north of
BLM rock road. Merchantable timber to east. 30
foot tall reprod to west.

NEW REF.
5/8" x 30" IR / DCSO **PROT 7"** **BEARS N 50° E, 209**
PLSTC CAP

CS 67/55/36
3/3