

GOVERNMENT CORNER RESTORATION FORM

FILED

TOWNSHIP 26S RANGE 31W SEC. 21

PLSS # 340340

Date: 2/28/2023 By: X

This survey consists of:

Map: _____

DOUGLAS COUNTY OREGON

DATE 2-7-23

Narrative: _____

Corner Rpt: CS 67/55-39

DOUGLAS COUNTY
SURVEYOR

Corner Designation

C 1/4 S21

Monument(s) Found: (Condition and Source)

3 1/4" BLM BRASS CAP ON 2"

I.D.I.P. 4P 8"

___ Condition report

___ Not Found

Renewed

___ Unrecorded

___ Surveyed In

Previous Renewals

Germond 1908 Vol 2 pg 153-154

BLM Subdivision of Section

1962-1963 Vol 32 pg 13398-99

DCSO 2000 CS File 66/18-6

MONUMENT DETAIL

C 1/4 S21

1963

Accessories Found

1" O.D. Rifle Barrel 6" below ground bears
S24°E 46.2 FT (set by DCSO in 1908 for Cor.)

35" W. OAK N80°W 188.3 FT GOOD SCAR

2" Capped Well Pipe projecting 13"
bears N 65 1/2° W 83.9 FT OCRS B&D (Rec N 65°W
82.0 FT)

20" D. Fir S21 1/4° E 343.0 FT Fully Healed
Double Blaze

5" Capped Well Pipe projecting 12" bears
N 12 1/2° W 74.0 FT OCRS B&D (Rec N 10 3/4° W 73.5 FT)

C.S. File 67/55-39

1/4

RENEWAL

Monument Set (Procedure and Description)

MONUMENT DETAIL

Blank lines for Monument Set description.

New Accessories

5/8" X 30" IRON ROD WITH DCSO yellow PLASTIC CAP EAST 10.0 FT


Sketch of Monument, Accessories, and General Area

Location & Comments

DCRS COORDINATES Cottage GROVE CANYONVILLE ZONE
N 167860.477
E 236909.553

AREA BURNT 9-2020

Comp. Decline. 14 1/2° E
Agency DCSO
Party Chief S. F. AUSE
Note keeper
Witnesses J. LORSUN

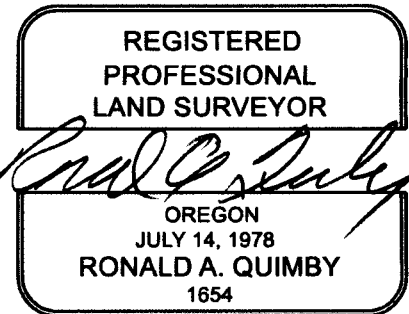

CS 67/55-39
24

RENEWED 2/7/23

TOWNSHIP 26 RANGE 03 POINT IDENTIFIER # 340340

PRIMARY CORNER DESCRIPTION Center 1/4 Cor. Section 21

Alias _____	Description _____
Alias _____	Description _____
Alias _____	Description _____
Alias _____	Description _____

M. B. Germond, Deputy For: O. E. Smith, Sept. 1908
 Volume 2 Pages 153-154

I drove Rifle Barrel 1 1/4" dia., 2 1/2 ft. in the ground and set East of it 2", a Red Fir post 4" x 4" x 3 ft., from which

- W.Oak 8" dia., bears N.61°07'W., 3.03 lks. dist.
- R.Fir 18" dia., bears S.37°48'E., 45.9 lks. dist.
- B.Oak 14" dia., bears S.31°15'W., 5.90 lks. dist.

Bureau of Land Management subdivision of Section by White; Beck and Reynolds, Under Group #'s 242; 491 and 527. Survey June 1962-Aug. 1963 (DCSO records, Volume 32 Pages 13398-99)

Point for the center 1/4 sec. cor. of sec. 21, at intersection with the E. and W. center line.
 Set an Iron Post, 28" long 2 1/2" dia., 24" in the ground, with brass cap mkd. C 1/4 S21
 1963

from which

- A Fir 20" dia., bears S.14°W., 649 lks., mkd. C 1/4 S21 BT.
- A W.Oak 22" dia. bears N.72 1/4°W. 252 lks., mkd. C 1/4 S21 BT

From this point, a local center 1/4 sec. cor. established by M.B. Germond in 1908, bears S.24°00'E., 0.70 chs. dist., at the corner of 2 fences. A barbed wire fence extends W., and a woven and barbed wire fence extends N. Point determined at record distance from Germond's bearing trees:

- A rotted Fir stump bears S.37 1/2°E., 459 lks. dist.
- An Oak stump shell bears S.31 3/4°W., 590 lks. dist.
- A W.Oak 23" dia., bears N.61°W., 303 lks. dist., with a healed blaze.

IN FEMA BURN RECOVERY AREA BUT NOT BURNED

Douglas Co. Surveyors Office - Randall W. Smith, Deputy - Stephen J. Flause - 11/2/2000 - C.S. File 66/18-6

Found - ^{3 1/4"} 1963 BLM brass cap/iron pipe, protrudes 8" out of ground in a N-S fence line 41 ft. north of a fence corner w/fence line running North & West.

^{3 1/4" BC/2" ID IP} 22" now 20" dia., down & rotted oak, no scribing visible root hole bears N.72 1/4°W., 166.3 ft. 1963

MARKED AS DESCRIBED No other BTs found.

✓ 1" O.D. rifle barrel 6" below ground bears S.24°E 46.2 ft. (agrees w/1963 BLM rec.) Set by DCSO in 1908 for cor.

New - 35" ~~32~~ dia., W.Oak double blazed & scribed "C 1/4 S21 CS BT" bears N.80°W., 188.3 ft.

continued next page
 ORCS CANYONVILLE POSITION
 167860, 477N, 236909, 553E

CS 67/55-39
 314 1

TOWNSHIP 26 RANGE 03 POINT IDENTIFIER # 340340

PRIMARY CORNER DESCRIPTION Center 1/4 Cor. Sec. 21

Alias _____ Description _____
Alias _____ Description _____
Alias _____ Description _____
Alias _____ Description _____

LIVE 20" 7" \checkmark dia., capped well pipe protruding 13" \checkmark above ground bears N ~~65~~^{65 1/2}°W., ~~82.0~~^{83.9} ft. *ORCS B&D*
13" dia., D. Fir double blazed & scribed "C/4 S21 CS BT" bears S. 21 1/4° E \checkmark , 343.0 ft. *FHDB*
7" \checkmark dia., capped well pipe protrudes 12" \checkmark above ground bears N. 10 3/4° W., ~~73.5~~^{74.0} ft. *ORCS B&D*
Note - Bearings need to be taken away from well casing as they effect bearings.
Dec. 17 3/4° E.

5/8" x 30" IR EAST, 10'
WITH DCSD PLSTC CAP

CS 62/55-39
4/4 2